RECEIVED 80

UCT 07 2011

WATER RESOURCES DEPT
SALEM, OREGON

STATE OF OREGON
WATER SUPPLY WELL REPORT
(as required by ORS 537.765)

WELL I.D. # L 107803

START CARD # 1015002

Instructions for completing this report are on the last page of this form.

(1) LAND OWNER Well Number _____
Name HOWARD THOMPSON
Address 6668 ROGUE RIVER DR.
City SHADY COVE State OR. Zip 97539

(2) TYPE OF WORK ☑ New Well
☐ Deepening ☐ Alteration (repair/recondition) ☐ Abandonment ☐ Conversion

(3) DRILL METHOD
☑ Rotary Air ☐ Rotary Mud ☐ Cable ☐ Auger ☐ Cable Mud
☐ Other _____

(4) PROPOSED USE
☑ Domestic ☐ Community ☐ Industrial ☐ Irrigation
☐ Thermal ☐ Injection ☐ Livestock ☐ Other _____

(5) BORE HOLE CONSTRUCTION Special Construction: ☐ Yes ☑ No
Depth of Completed Well 200 ft.
Explosives used: ☐ Yes ☑ No Type _____ Amount _____

BORE HOLE Diameter	From	To	SEAL Material	From	To	Sacks or Pounds
10"	0	27	CEMENT	0	27	8 SACKS
6"	27	200				

How was seal placed: Method ☐ A ☐ B ☑ C ☐ D ☐ E
☐ Other _____
Backfill placed from _____ ft. to _____ ft. Material _____
Gravel placed from _____ ft. to _____ ft. Size of gravel _____

(6) CASING/LINER

	Diameter	From	To	Gauge	Steel	Plastic	Welded	Threaded
Casing:	6"	+ 1	27	.250	☑	☐	☑	☐
					☐	☐	☐	☐
					☐	☐	☐	☐
					☐	☐	☐	☐
Liner:	4"	0	200	160	☐	☑	☑	☐
					☐	☐	☐	☐

Drive Shoe used ☐ Inside ☑ Outside ☐ None
Final location of shoe(s) _____

(7) PERFORATIONS/SCREENS
☑ Perforations Method SAW
☐ Screens Type _____ Material _____

From	To	Slot Size	Number	Diameter	Tele/pipe size	Casing	Liner
140	180	1X8X8	45	4"		☐	☑
						☐	☐
						☐	☐
						☐	☐
						☐	☐

(8) WELL TESTS: Minimum testing time is 1 hour
☐ Pump ☐ Bailer ☑ Air ☐ Flowing Artesian

Yield gal/min	Drawdown	Drill stem at	Time
2.5 GPM		200	1 HOUR

Temperature of water 57 Depth Artesian Flow Found _____
Was a water analysis done? ☐ Yes By whom _____
Did any strata contain water not suitable for intended use? ☐ Too little
☐ Salty ☐ Muddy ☐ Odor ☐ Colored ☐ Other _____
Depth of strata: _____

(9) LOCATION OF WELL (legal description)
County JACKSON
Tax Lot 1500 Lot _____
Township 34 S Range 1 W WM
Section 15 _____ 1/4 _____ 1/4
Lat 42 ° 37 ' 1 " or _____.____ (degrees or decimal)
Long 122 ° 48 ' 35 " or _____.____ (degrees or decimal)
Street Address of Well (or nearest address) 120 HEATHER LN
SHADY COVE

(10) STATIC WATER LEVEL
52 ft. below land surface. Date 9-29-11
_____ ft. below land surface. Date _____
Artesian pressure _____ lb. per square inch Date _____

(11) WATER BEARING ZONES
Depth at which water was first found 151

From	To	Estimated Flow Rate	SWL
151	178	2.5 GPM	52

(12) WELL LOG Ground Elevation _____

Material	From	To	SWL
SOIL ,BROWN	0	1	
GRAVEL,SMALL, SANDY	1	3	
CONGLOMERATE ,GREY	3	22	
CLAYSTONE,RED	22	166	
CLAYSTONE,RED,GREY,SEAMS	166	180	
CLAYSTONE,GREY,SOFT	180	200	52

Date Started 9-28-11 Completed 9-29-11

(unbonded) Water Well Constructor Certification
I certify that the work I performed on the construction, deepening, alteration, or abandonment of this well is in compliance with Oregon water supply well construction standards. Materials used and information reported above are true to the best of my knowledge and belief.

WWC Number Medina Well Drilling, Inc.
(541) 664-6339
Signed 3266 Hanley Road
Central Point, OR 97502

(bonded) Water Well Constructor Certification
I accept responsibility for the construction, deepening, alteration, or abandonment work performed on this well during the construction dates reported above. All work performed during this time is in compliance with Oregon water supply well construction standards. This report is true to the best of my knowledge and belief.

WWC Number 1207 Date 10-5-11
Signed Joaquin Medina Jr

ORIGINAL – WATER RESOURCES DEPARTMENT FIRST COPY – CONSTRUCTOR SECOND COPY – CUSTOMER 06/16/2004

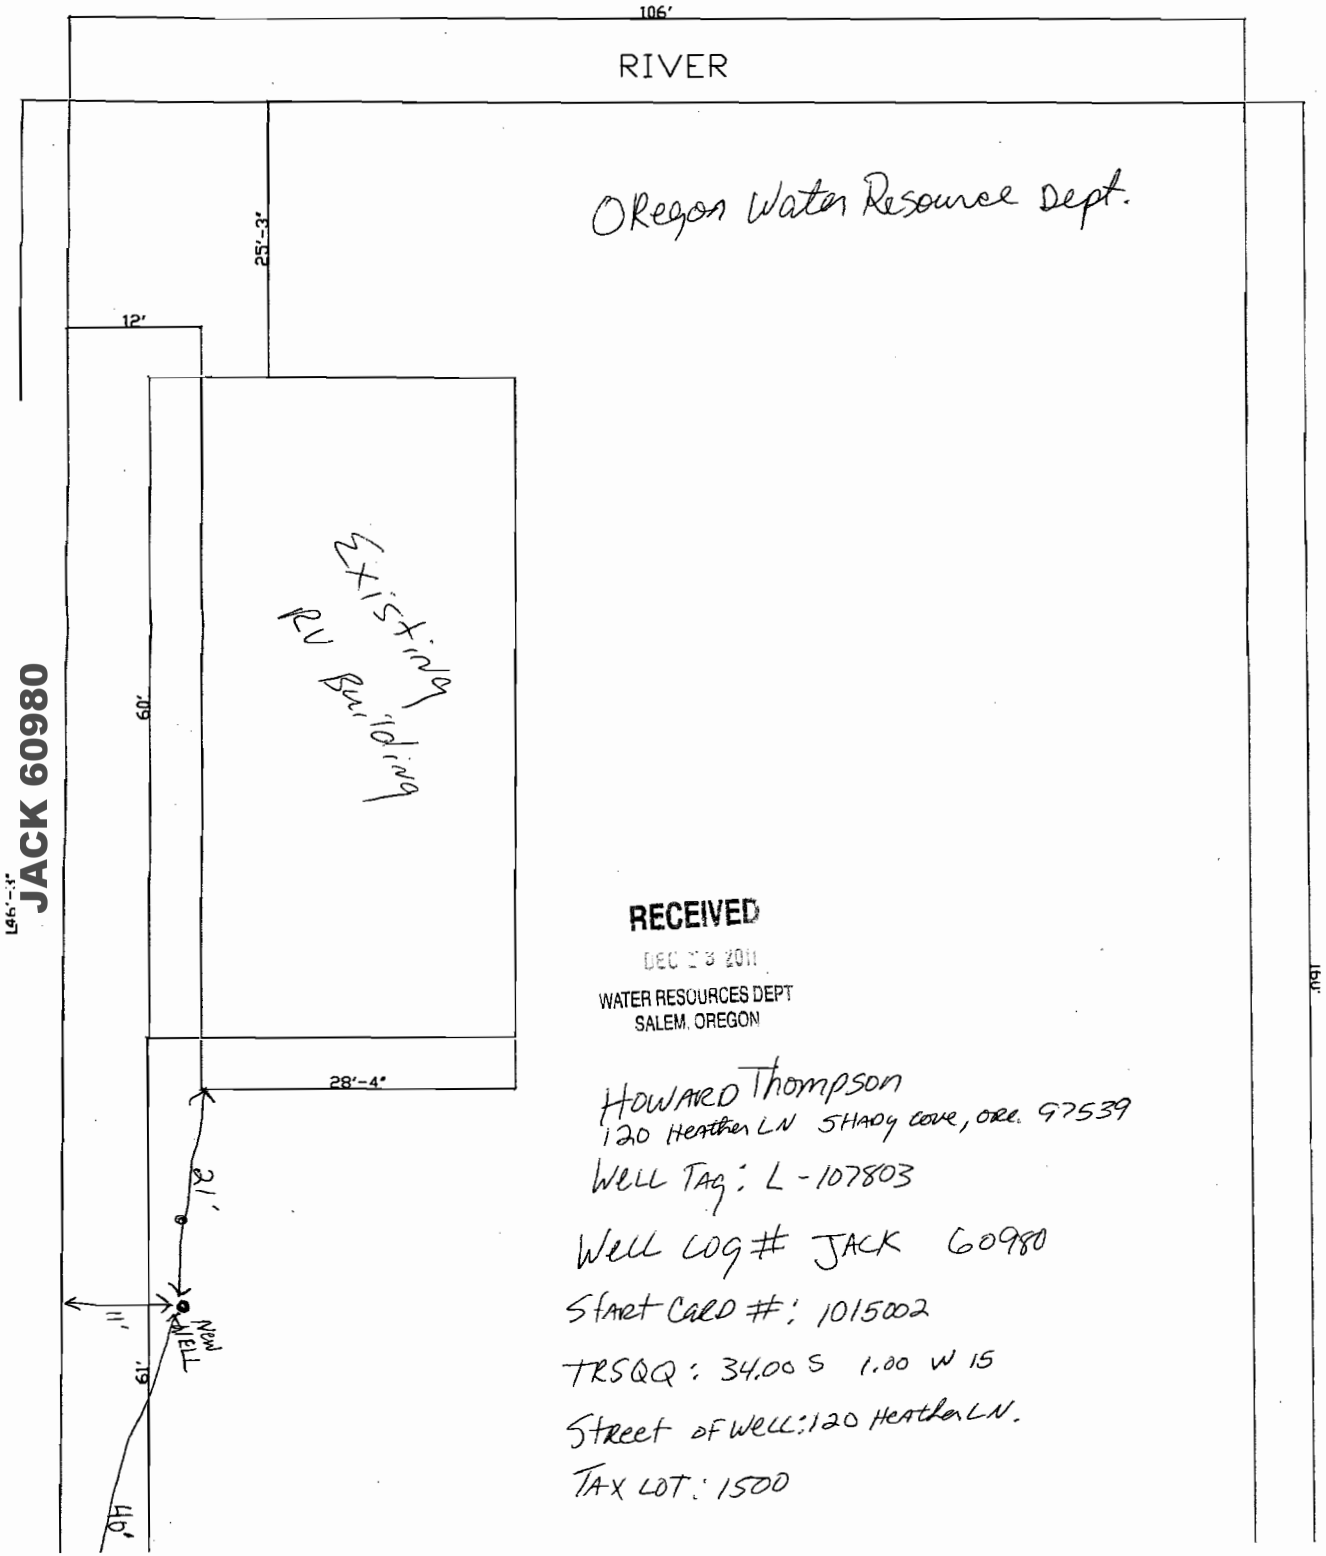

RECEIVED
DEC 23 2011
WATER RESOURCES DEPT
SALEM, OREGON

Howard Thompson
120 Heather LN Shady Cove, Ore. 97539
Well Tag: L-107803
Well Log # JACK 60980
Start Card #: 1015002
TRSQQ: 34.00 S 1.00 W 15
Street of Well: 120 Heather LN.
Tax Lot: 1500