

STATE ENGINEER
Salem, Oregon

Jack
6370

Well Record

GR- 1559


STATE WELL NO. 36/1W-30N
COUNTY Jackson
APPLICATION NO. GR-1607

OWNER: Clyde Crenshaw MAILING ADDRESS: Rt. 2, Box 187

LOCATION OF WELL: Owner's No. #1 CITY AND STATE: Central Point, Oregon

SW $\frac{1}{4}$ SW $\frac{1}{4}$ Sec. 30 T. 36 S., R. 1 W., W.M.

Bearing and distance from section or subdivision corner Approx. 500' SW of Center of Sec. 30

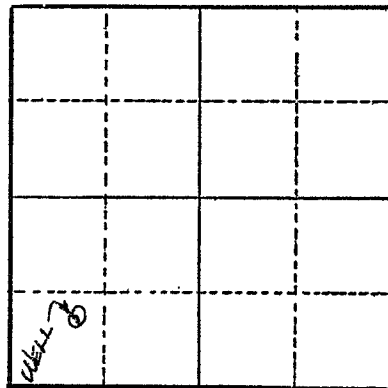

Section 30

Altitude at well _____

TYPE OF WELL: Drilled Date Constructed 1953

Depth drilled 60' Depth cased 60'

CASING RECORD:

6"

FINISH:

Perforated

AQUIFERS:

WATER LEVEL:

15'

PUMPING EQUIPMENT: Type Gorden 3 $\frac{1}{2}$ " turbine H.P. 7 $\frac{1}{2}$
Capacity 320 G.P.M.

WELL TESTS:

Drawdown _____ ft. after _____ hours _____ G.P.M.

Drawdown _____ ft. after _____ hours _____ G.P.M.

USE OF WATER Irrigation Temp. _____ °F., 19 _____

SOURCE OF INFORMATION GR Record

DRILLER or DIGGER Neel's Well Drilling

ADDITIONAL DATA:

Log N.A. Water Level Measurements _____ Chemical Analysis _____ Aquifer Test _____

REMARKS:

Irrigation of 54 acres.