

STATE ENGINEER  
Salem, Oregon

# Well Record

STATE WELL NO. 36/1W-30N...  
COUNTY Jackson...  
APPLICATION NO. GR-1608...

*Jack*  
*6571*

GR- 1560

OWNER: Clyde Crenshaw


MAILING ADDRESS: Rt. 2, Box 187

LOCATION OF WELL: Owner's No. #3

CITY AND STATE: Central Point, Oregon

SW ¼ SW ¼ Sec. 30 T. 36 S., R. 1 W., W.M.

Bearing and distance from section or subdivision corner Approx. 300' S. of NE cor. of SW ¼ SW ¼ of Section 30

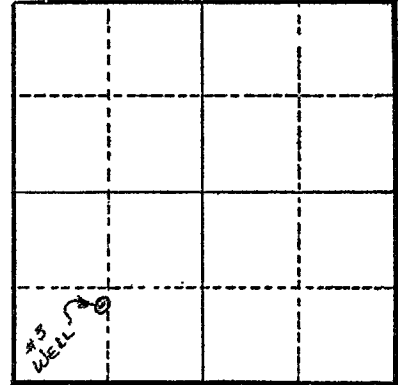

Section 30

Altitude at well

TYPE OF WELL: Drilled Date Constructed 1953

Depth drilled 88' Depth cased 88'

CASING RECORD:

6"

FINISH:

Perforated

AQUIFERS:

WATER LEVEL:

15'

PUMPING EQUIPMENT: Type 2" turbine H.P. 7  
Capacity 136 G.P.M.

WELL TESTS:

Drawdown ft. after hours G.P.M.  
Drawdown ft. after hours G.P.M.

USE OF WATER Irrigation Temp. °F. 19

SOURCE OF INFORMATION GR Record

DRILLER or DIGGER

ADDITIONAL DATA:

Log N.A. Water Level Measurements Chemical Analysis Aquifer Test

REMARKS:

Irrigation of 25 acres.