

STATE ENGINEER
Salem, Oregon

Jack
6572

Well Record

STATE WELL NO. 36/1W-30P
COUNTY Jackson
APPLICATION NO. GR-1609

GR- 1561

OWNER: Clyde Crenshaw


MAILING ADDRESS: Rt. 2, Box 187

LOCATION OF WELL: Owner's No. #2

CITY AND STATE: Central Point, Oregon

SE 1/4 SW 1/4 Sec. 30 T. 36 S., R. 1 W., W.M.

Bearing and distance from section or subdivision corner 500' N. & 500' W. from S¹/₄ cor. Sec. 30

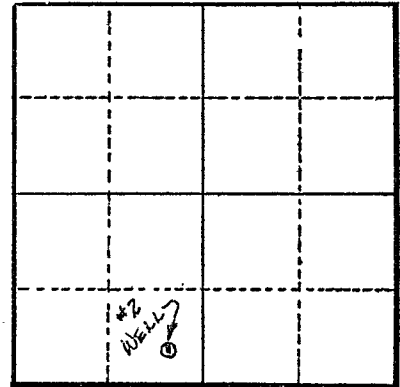

Section 30

Altitude at well 1375'

TYPE OF WELL: Drilled Date Constructed 1953

Depth drilled 94' Depth cased 94'

CASING RECORD:
6"

FINISH:
Perforated

AQUIFERS:

WATER LEVEL:
15'

PUMPING EQUIPMENT: Type 2" turbine H.P. 7
Capacity 130 G.P.M.

WELL TESTS:
Drawdown ft. after hours G.P.M.
Drawdown ft. after hours G.P.M.

USE OF WATER Irrigation Temp. °F., 19.....

SOURCE OF INFORMATION GR Record

DRILLER or DIGGER Neel's Well Drilling

ADDITIONAL DATA:
Log N.A. Water Level Measurements Chemical Analysis Aquifer Test

REMARKS:
Irrigation of 13 acres.