STATE OF OREGON
WATER SUPPLY WELL REPORT
(as required by ORS 537.545 & 537.765 and OAR 690-205-0210)

JACK 66181
5/4/2024

WELL I.D. LABEL# L 146681
START CARD # 1073463
ORIGINAL LOG #

(1) LAND OWNER

Owner Well I.D.
First Name DR. PAUL Last Name SCHULTZ
Company
Address 6701 OLD FERRY ROAD
City SHADY COVE State OR Zip 97539

(2) TYPE OF WORK

[X] New Well [ ] Deepening [ ] Conversion
[ ] Alteration (complete 2a & 10) [ ] Abandonment(complete 5a)

(2a) PRE-ALTERATION

	Dia	+	From	To	Gauge	Stl	Plstc	Wld	Thrd
Casing:									

	Material	From	To	Amt	sacks/lbs
Seal:					

(3) DRILL METHOD

[X] Rotary Air [ ] Rotary Mud [ ] Cable [ ] Auger [ ] Cable Mud
[ ] Reverse Rotary [ ] Other

(4) PROPOSED USE

[X] Domestic [ ] Irrigation [ ] Community
[ ] Industrial/ Commericial [ ] Livestock [ ] Dewatering
[ ] Thermal [ ] Injection [ ] Other

(5) BORE HOLE CONSTRUCTION

Special Standard [ ] (Attach copy)
Depth of Completed Well 300.00 ft.

BORE HOLE Dia	From	To	SEAL Material	From	To	Amt	sacks/lbs
12	0	38	Bentonite Chips	0	38	34	S
5.5	38	300			Calculated	31	
					Calculated		

Seal placement method: [ ] A [ ] B [ ] C [ ] D [ ] E [X] Other: DRY POURED
Backfill placed from ft. to ft. Material
Filter pack from ft. to ft. Material Size
Explosives used: [ ] Type Amount
Seal Placement Begin Date 4/25/2024 Begin Time 16 00

(5a) ABANDONMENT USING UNHYDRATED BENTONITE

Proposed Amount Actual Amount

(6) CASING/LINER

Casing	Liner	Dia	+	From	To	Gauge	Stl	Plstc	Wld	Thrd
(•)	( )	6	[X]	2	38	.250	(•)	( )	[X]	[ ]
( )	( )		[ ]				( )	( )	[ ]	[ ]
( )	( )		[ ]				( )	( )	[ ]	[ ]
( )	( )		[ ]				( )	( )	[ ]	[ ]
( )	( )		[ ]				( )	( )	[ ]	[ ]

Shoe [ ] Inside [ ] Outside [X] Other Location of shoe(s) 38
Temp casing [ ] Yes Dia From + [ ] To

(7) PERFORATIONS/SCREENS

Perforations Method
Screens Type Material

Perf/ Screen	Casing/ Liner	Screen Dia	From	To	Scrn/slot width	Slot length	# of slots	Tele/ pipe size

(8) WELL TESTS: Minimum testing time is 1 hour

( ) Pump ( ) Bailer (•) Air ( ) Flowing Artesian

Yield gal/min	Drawdown	Drill stem/Pump depth	Duration (hr)
0.5		300	2

Temperature 54 °F Lab analysis [ ] Yes By
Water quality concerns? [ ] Yes (describe below) TDS amount 154 ppm

From	To	Description	Amount	Units

(9) LOCATION OF WELL (legal description)

County JACKSON Twp 33.00 S N/S Range 1.00 W E/W WM
Sec 36 SE 1/4 of the NW 1/4 Tax Lot 1300
Tax Map Number Lot
Lat ° ' " or 42.65795876 DMS or DD
Long ° ' " or -122.76814627 DMS or DD
(•) Street address of well ( ) Nearest address
6701 OLD FERRY ROAD, SHADY COVE, OR 97539

(10) STATIC WATER LEVEL

	Date	SWL(psi)	+	SWL(ft)
Existing Well / Pre-Alteration			[ ]	
Completed Well	5/3/2024		[ ]	75

Flowing Artesian? [ ] Dry Hole? [ ]

WATER BEARING ZONES Depth water was first found 160.00

SWL Date	From	To	Est Flow	SWL(psi)	+	SWL(ft)
5/3/2024	160	180	0.5		[ ]	75
					[ ]	
					[ ]	
					[ ]	
					[ ]	

(11) WELL LOG

Ground Elevation 1474.21 FT

Material	From	To
Top soil, brown	0	12
sandy clay/soil w/ small boulders	12	28
Basalt, blue/grey, consolidated, Med	28	80
Basalt, black, reddish streaks med hard	80	150
Basalt, Tan/grey, Med	150	300

Construction
Begin Date 4/25/2024 Begin Time 16 00 End Date 5/3/2024

(unbonded) Water Well Constructor Certification

I certify that the work I performed on the construction, deepening, alteration, or abandonment of this well is in compliance with Oregon water supply well construction standards. Materials used and information reported above are true to the best of my knowledge and belief.

License Number Date

Signed

(bonded) Water Well Constructor Certification

I accept responsibility for the construction, deepening, alteration, or abandonment work performed on this well during the construction dates reported above. All work performed during this time is in compliance with Oregon water supply well construction standards. This report is true to the best of my knowledge and belief.

License Number 1798 Date 5/4/2024

Signed GARY NEWMAN (E-filed)

Contact Info (optional) Southern Oregon Well Drilling Inc.

WATER SUPPLY WELL REPORT - continuation page

JACK 66181

5/4/2024

WELL I.D. LABEL# L 146681
START CARD # 1073463
ORIGINAL LOG #

(2a) PRE-ALTERATION

Dia	+	From	To	Gauge	Stl	Plstc	Wld	Thrd

Material	From	To	Amt	sacks/lbs

(5) BORE HOLE CONSTRUCTION

BORE HOLE Dia	From	To

SEAL Material	From	To	Amt	sacks/lbs
		Calculated		
		Calculated		
		Calculated		
		Calculated		

FILTER PACK

From	To	Material	Size

(6) CASING/LINER

Casing Liner	Dia	+	From	To	Gauge	Stl	Plstc	Wld	Thrd

(7) PERFORATIONS/SCREENS

Perf/ Screen	Casing/ Liner	Screen Dia	From	To	Scrn/slot width	Slot length	# of slots	Tele/ pipe size

(8) WELL TESTS: Minimum testing time is 1 hour

Yield gal/min	Drawdown	Drill stem/Pump depth	Duration (hr)

Water Quality Concerns

From	To	Description	Amount	Units

(10) STATIC WATER LEVEL

SWL Date	From	To	Est Flow	SWL(psi)	+	SWL(ft)

(11) WELL LOG

Material	From	To

WATER SUPPLY WELL REPORT - Map with location identified must be attached and shall include an approximate scale and north arrow

JACK 66181

5/4/2024

Map of Hole

STATE OF OREGON
WELL LOCATION MAP

This map is supplemental to the WATER SUPPLY WELL REPORT

Oregon Water Resources Department
725 Summer St NE, Salem OR 97301
(503)986-0900

LOCATION OF WELL

Latitude: 42.65795876 Datum: WGS84
Longitude: -122.76814627
Township/Range/Section/Quarter-Quarter Section:
WM33.00S1.00W36SENW
Address of Well:
6701 OLD FERRY ROAD, SHADY COVE, OR 97539

Well Label: 146681

Printed: May 4, 2024

DISCLAIMER: This map is intended to represent the approximate location the well. It is not intended to be construed as survey accurate in any manner.
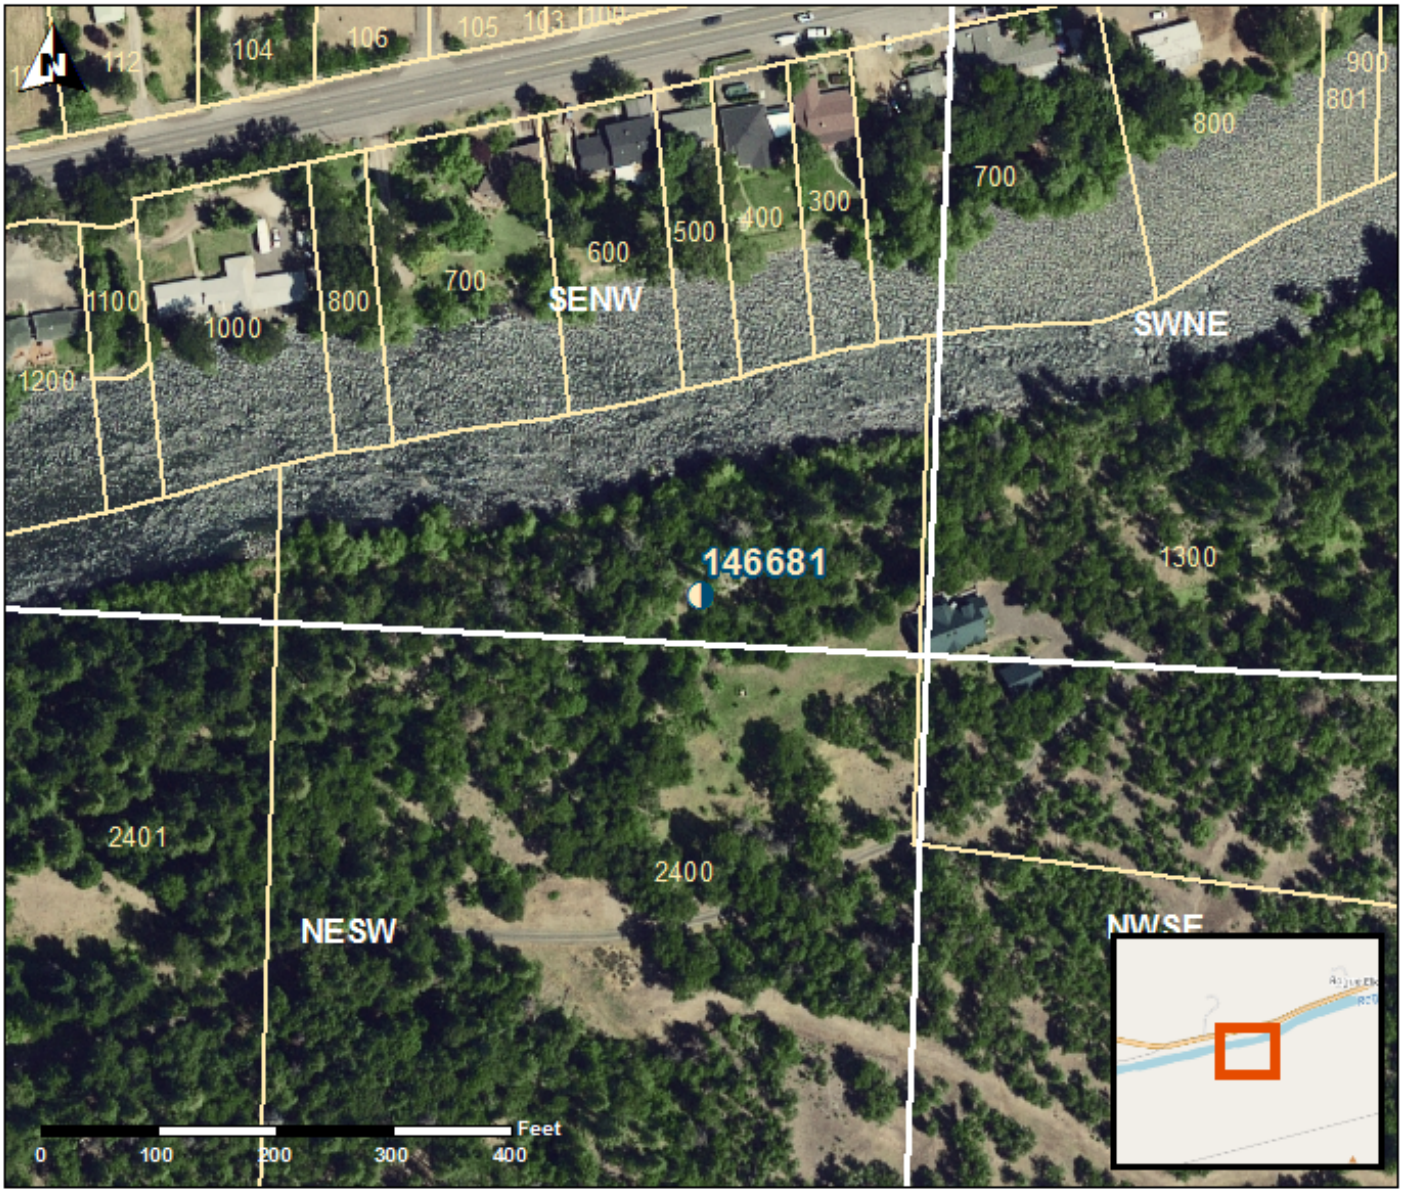
Provided by well constructor