

STATE ENGINEER
Salem, Oregon

2023
Jack

Well Record

STATE WELL NO. 36/2W-21C(1)
COUNTY Jackson
APPLICATION NO. GR-452

OWNER: C. D. Kendall

MAILING ADDRESS:

Box 306

LOCATION OF WELL: Owner's No.


CITY AND STATE:

Central Point, Oregon

NE 1/4 NW 1/4 Sec. 21 T. 36 N. R. 2 E. W.M.

Bearing and distance from section or subdivision

corner S. 660' & W. 65' from NW cor. Sec. 21

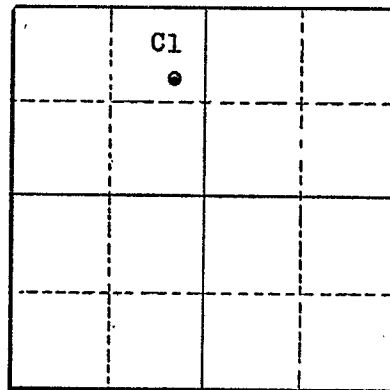

Section 21

Altitude at well 1170

TYPE OF WELL: Trench Date Constructed May 15, '49

Depth drilled Dug Depth cased none

CASING RECORD:

FINISH:

AQUIFERS:

WATER LEVEL:

PUMPING EQUIPMENT: Type Cornell H.P. 25
Capacity 100 G.P.M.

WELL TESTS:

Drawdown ft. after hours G.P.M.
Drawdown ft. after hours G.P.M.

USE OF WATER Irrigation 7 acres Temp. °F., 19

SOURCE OF INFORMATION GR-452

DRILLER or DIGGER

ADDITIONAL DATA:

Log No Water Level Measurements Chemical Analysis Aquifer Test

REMARKS:

Infiltration trench: 40 x 80' 20 to 25' deep