

STATE ENGINEER
Salem, Oregon

Jack
7301

Well Record


STATE WELL NO. 36/2W-25K
COUNTY Jackson
APPLICATION NO. GR-3388

OWNER: Joseph A. Bowdoin and Margaret A. Bowdoin
MAILING ADDRESS: Route 2, Box 195-B

LOCATION OF WELL: Owner's No. _____
CITY AND STATE: Central Point, Oregon

NE $\frac{1}{4}$ NW $\frac{1}{4}$ SE $\frac{1}{4}$ Sec. 25 T. 36 N. S., R. 2 W., W.M.

Bearing and distance from section or subdivision corner 47' S. and 1118' E.

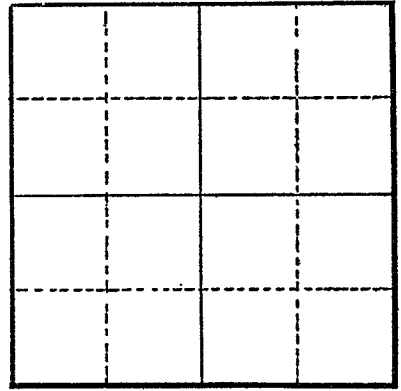

Section

Altitude at well

TYPE OF WELL: drilled Date Constructed 1955

Depth drilled 32' Depth cased 30 $\frac{1}{2}$ '

CASING RECORD:
6"

FINISH:

AQUIFERS:

topsoil, clay, sand and gravel

WATER LEVEL:

8'

PUMPING EQUIPMENT: Type 1 $\frac{1}{2}$ " x 1 $\frac{1}{4}$ " Deep well Jet H.P. 1
Capacity 25 G.P.M.

WELL TESTS:

Drawdown ft. after hours pumping 33 G.P.M.
Drawdown ft. after hours G.P.M.

USE OF WATER Irrigation Temp. °F., 19

SOURCE OF INFORMATION GR-3129

DRILLER or DIGGER Rogue Valley Drilling Co., 885 Shafer Lane, Medford, Oregon

ADDITIONAL DATA:

Log Water Level Measurements Chemical Analysis Aquifer Test

REMARKS:

32
topsoil 3
yellow clay 9
sandy yellow clay 13
(water bearing) sand & gravel 7