

STATE ENGINEER
Salem, Oregon

Jack
7304

Well Record

STATE WELL NO. 36/2W-25F
COUNTY Jackson
APPLICATION NO. GR-1499

GR- 1449

OWNER: Carl Hasler


MAILING ADDRESS: Rt. 2, Box 204

LOCATION OF WELL: Owner's No. _____

CITY AND STATE: Central Point, Oregon

SE 1/4 NW 1/4 Sec. 25 T. 36 S., R. 2 W., W.M.

Bearing and distance from section or subdivision
corner 2110' S. & 281' W. from N 1/4 cor. Sec. 25.

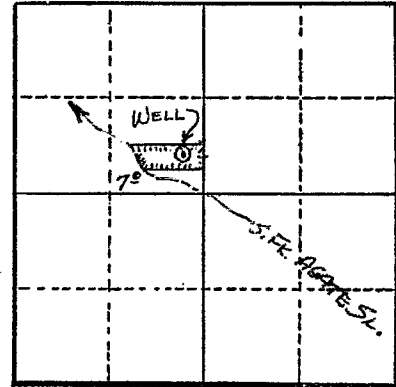

Section 25

Altitude at well 1255'

TYPE OF WELL: Drilled Date Constructed 1953

Depth drilled 180' Depth cased 180'

CASING RECORD:

8" from 0 to 40'

FINISH:

2 perforations per ft. being 1/4" x 2 1/2" slots from 20 to 40 ft.

AQUIFERS:

WATER LEVEL:

10'

PUMPING EQUIPMENT: Type F. M. 3" turbine H.P. 5
Capacity 100 G.P.M.

WELL TESTS:

Drawdown 50 ft. after _____ hours 100 G.P.M.

Drawdown _____ ft. after _____ hours _____ G.P.M.

USE OF WATER Irrigation Temp. _____ °F., 19 _____

SOURCE OF INFORMATION GR Record

DRILLER or DIGGER Grater Well Drilling

ADDITIONAL DATA:

Log _____ Water Level Measurements _____ Chemical Analysis _____ Aquifer Test _____

REMARKS:

Log: Black clay 0 to 4 ft.
Cement gravel 4 to 10 ft.
Yellow clay 10 to 18 ft.
Dark gray clay 18 to 180 ft.
Water bearing at 30' & 75'

Irrigation of 7 acres.