

STATE ENGINEER
Salem, Oregon

Jack
7306

Well Record

STATE WELL NO. 36/2W - 25C
COUNTY JACKSON
APPLICATION NO. GR-2083

OWNER: Hollie F. Swingle


MAILING ADDRESS: Rt. 2, Box 210

LOCATION OF WELL: Owner's No. _____

CITY AND STATE: Central Point, Oregon

NE 1/4 NW 1/4 Sec. 25 T. 36 S., R. 2 W., W.M.

Bearing and distance from section or subdivision corner 450' W. & 600' S.

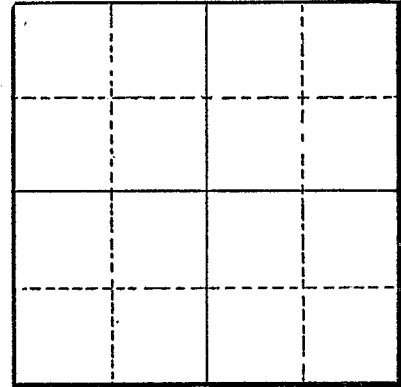

Section _____

Altitude at well _____

TYPE OF WELL: Drilled Date Constructed 1951

Depth drilled 102 Depth cased 50

CASING RECORD:

8-inch

FINISH:

Perforations from 20 to 50

AQUIFERS:

Shale and sand

WATER LEVEL:

15-feet

PUMPING EQUIPMENT: Type Pacific Submersible H.P. 4
Capacity 100 G.P.M.

WELL TESTS:

Drawdown 80 ft. after _____ hours _____ G.P.M.
Drawdown _____ ft. after _____ hours _____ G.P.M.

USE OF WATER Irrigation Temp. _____ °F. _____, 19_____

SOURCE OF INFORMATION GR-2001

DRILLER or DIGGER Chitwood, Crater Drilling

ADDITIONAL DATA:

Log Water Level Measurements _____ Chemical Analysis _____ Aquifer Test _____

REMARKS:

