

STATE ENGINEER  
Salem, Oregon

JACK  
7307

# Well Record


STATE WELL NO. 36/2W-25F  
COUNTY Jackson  
APPLICATION NO. GR-2097

OWNER: Hazel Roderick  
MAILING ADDRESS: Route 2, Box 206

LOCATION OF WELL: Owner's No. \_\_\_\_\_  
CITY AND STATE: Central Point, Oregon

N  $\frac{1}{2}$  SE  $\frac{1}{4}$  NW  $\frac{1}{4}$  Sec. 25 T. 36 N. S., R. 2 E. W., W.M.

Bearing and distance from section or subdivision  
corner 1340' S & 815' W

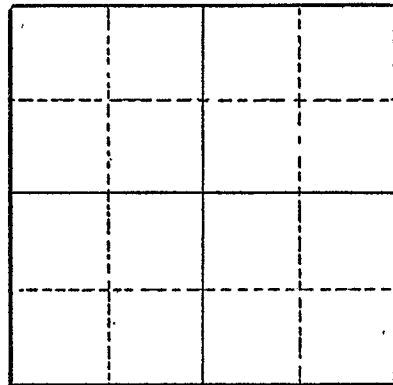

Section

Altitude at well \_\_\_\_\_

TYPE OF WELL: Dug Date Constructed 1950

Depth drilled 14 Depth cased \_\_\_\_\_

### CASING RECORD:

### FINISH:

### AQUIFERS:

### WATER LEVEL:

6'

PUMPING EQUIPMENT: Type Pacific centrifugal H.P. 3  
Capacity \_\_\_\_\_ G.P.M.

### WELL TESTS:

Drawdown \_\_\_\_\_ ft. after \_\_\_\_\_ hours \_\_\_\_\_ G.P.M.

Drawdown \_\_\_\_\_ ft. after \_\_\_\_\_ hours \_\_\_\_\_ G.P.M.

USE OF WATER Irrigation Temp. \_\_\_\_\_ °F. \_\_\_\_\_, 19

SOURCE OF INFORMATION GR-2014

DRILLER or DIGGER \_\_\_\_\_

### ADDITIONAL DATA:

Log \_\_\_\_\_ Water Level Measurements \_\_\_\_\_ Chemical Analysis \_\_\_\_\_ Aquifer Test \_\_\_\_\_

### REMARKS: