

STATE ENGINEER
Salem, Oregon

JACK
7308

Well Record

STATE WELL NO. 36/2W-25N
COUNTY Jackson
APPLICATION NO. GR-4276

OWNER: Charles E. Myrick MAILING ADDRESS: 326 Orr Drive
LOCATION OF WELL: Owner's No. _____ CITY AND STATE: Central Point, Oregon


SW $\frac{1}{4}$ SW $\frac{1}{4}$ Sec. 25 T. 36 S., R. 2 W., W.M.

Bearing and distance from section or subdivision corner 470 feet North and 1640 feet West from the S $\frac{1}{4}$ Corner, Section 25

Altitude at well 1260 feet

TYPE OF WELL: Drilled Date Constructed March 1950

Depth drilled 50 feet Depth cased 49 feet

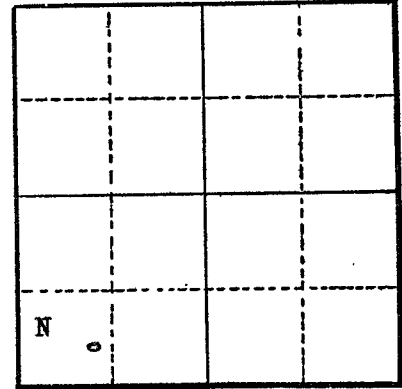

Section 25

CASING RECORD:

6-inch casing set from ground to 49 feet

FINISH:

AQUIFERS:

clay, sand, and gravel

WATER LEVEL:

8 feet

PUMPING EQUIPMENT: Type Montgomery Ward Jet (2hp) H.P. _____
Capacity 60 G.P.M.

WELL TESTS:

Drawdown 35 ft. after _____ hours 60 G.P.M.
Drawdown _____ ft. after _____ hours _____ G.P.M.

USE OF WATER Domestic and Irrigation Temp. _____ °F., 19 _____

SOURCE OF INFORMATION GR-4128

DRILLER or DIGGER _____

ADDITIONAL DATA:

Log Water Level Measurements _____ Chemical Analysis _____ Aquifer Test _____

REMARKS:

top soil 0 2
yellow clay 2 13
sandy yellow clay 13 28
sand and gravel 28 50