

STATE ENGINEER
Salem, Oregon

JACK
7526

Well Record

STATE WELL NO. 36/2W-28
COUNTY JACKSON
APPLICATION NO. GR-2606

OWNER: Wilson B. Dir. and Elsie Dir.


MAILING ADDRESS: 260 North 5th Street

LOCATION OF WELL: Owner's No.

CITY AND STATE: Central Point, Oregon

NE $\frac{1}{4}$ NE $\frac{1}{4}$ SW $\frac{1}{4}$ Sec. 28 T. 36 N. S., R. 2 E. W.M.

Bearing and distance from section or subdivision corner 3' N. and 2102' E. from the SW cor. of DLC #52.

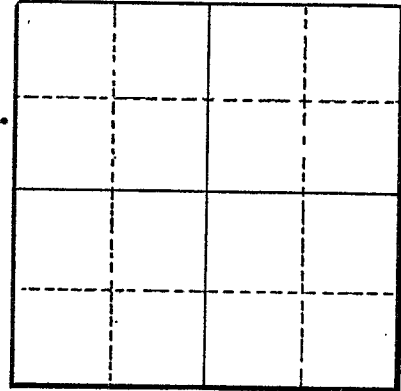

Section

Altitude at well

TYPE OF WELL: Dug Date Constructed 1952

Depth drilled 18 Depth cased 18

CASING RECORD:

8.0-inch

FINISH:

AQUIFERS:

WATER LEVEL:

4.0-feet

PUMPING EQUIPMENT: Type Wards Centrifugal Pump H.P. 3.0
Capacity 100 G.P.M.

WELL TESTS:

Drawdown ft. after hours G.P.M.

Drawdown ft. after hours G.P.M.

USE OF WATER Irrigation Temp. °F., 19

SOURCE OF INFORMATION GR-2473

DRILLER or DIGGER By claimant

ADDITIONAL DATA:

Log Water Level Measurements Chemical Analysis Aquifer Test

REMARKS: