

STATE ENGINEER
Salem, Oregon

*Jack
7763*

Well Record

STATE WELL NO. 36/2W-30K
COUNTY JACKSON
APPLICATION NO. GR-2883

OWNER: Benton A. Boyce

MAILING ADDRESS:

Central Point, Oregon


LOCATION OF WELL: Owner's No. _____

CITY AND STATE:

NW 1/4 SE 1/4 Sec. 30 T. 36 S., R. 2 W., W.M.

Bearing and distance from section or subdivision

corner 53' S. and 643' E.

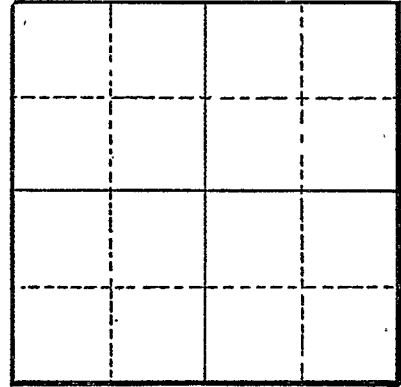

Section _____

Altitude at well _____

TYPE OF WELL: dug Date Constructed 1955

Depth drilled 18 Depth cased _____

CASING RECORD:

FINISH:

AQUIFERS:

WATER LEVEL:

4.0-feet

PUMPING EQUIPMENT: Type Centrifugal H.P. 8.0
Capacity _____ G.P.M.

WELL TESTS:

Drawdown _____ ft. after _____ hours _____ G.P.M.

Drawdown _____ ft. after _____ hours _____ G.P.M.

USE OF WATER irrigation Temp. _____ °F. _____, 19_____

SOURCE OF INFORMATION GR-2712

DRILLER or DIGGER _____

ADDITIONAL DATA:

Log _____ Water Level Measurements _____ Chemical Analysis _____ Aquifer Test _____

REMARKS: