

STATE ENGINEER
Salem, Oregon

Jack
7948

Well Record

STATE WELL NO. 36/2W - 34N
COUNTY JACKSON
APPLICATION NO. GR-2021

OWNER: R. P. Jensen (Russell Jensen)

MAILING ADDRESS: Rt. 1, Box 18


LOCATION OF WELL: Owner's No. _____

CITY AND STATE: Central Point, Oregon

$N\frac{1}{2}$ SW $\frac{1}{4}$ SW $\frac{1}{4}$ Sec. 34 T. 36 $N.$ S., R. 2 $W.$ W.M.

Bearing and distance from section or subdivision

corner 1474' S. and 990'E

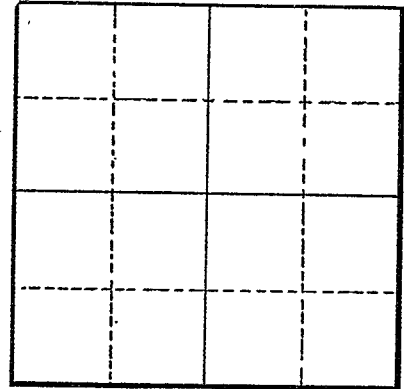

Section _____

Altitude at well _____

TYPE OF WELL: Dug Date Constructed 1954

Depth drilled 46 Depth cased 32 46

CASING RECORD:

24-inch

FINISH: _____

AQUIFERS: _____

WATER LEVEL:

10-feet

PUMPING EQUIPMENT: Type Centrifugal pump

H.P. 1.5

Capacity 40 est. G.P.M.

WELL TESTS:

Drawdown 15 ft. after _____ hours Pumping 40 G.P.M.

Drawdown _____ ft. after _____ hours _____ G.P.M.

USE OF WATER Irrigation

Temp. _____ °F., 19 _____

SOURCE OF INFORMATION GR-1948

DRILLER or DIGGER Robert Shand

ADDITIONAL DATA:

Log _____ Water Level Measurements _____ Chemical Analysis _____ Aquifer Test _____

REMARKS: _____