

STATE ENGINEER
Salem, Oregon

JACK
79419

Well Record

STATE WELL NO. 36/2W-34R(1)
COUNTY Jackson
APPLICATION NO. GR-491

OWNER: A. T. Lathrop


MAILING ADDRESS: Route 1, Box 595

LOCATION OF WELL: Owner's No. 1

CITY AND STATE: Central Point, Oregon

SE 1/4 SE 1/4 Sec. 34 T. 36 N. S., R. 2 E. W., W.M.

Bearing and distance from section or subdivision corner 15' N & 680' W. from SE cor. Sec. 34

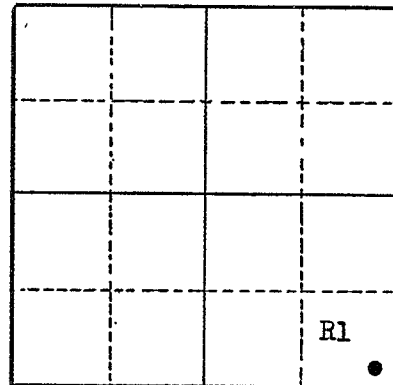

Section 34

Altitude at well 1225

TYPE OF WELL: Dug Date Constructed Sept 51

Depth drilled 12 Depth cased

CASING RECORD:

55' x 225' sump

FINISH:

AQUIFERS:

WATER LEVEL:

4'

PUMPING EQUIPMENT: Type Centrifugal H.P. 5
Capacity 144 G.P.M.

WELL TESTS:

Drawdown ft. after hours G.P.M.
Drawdown ft. after hours G.P.M.

USE OF WATER Irrigation 21 acres Temp. °F. 19

SOURCE OF INFORMATION GR-491

DRILLER or DIGGER

ADDITIONAL DATA:

Log No Water Level Measurements Chemical Analysis Aquifer Test

REMARKS: