

STATE ENGINEER
Salem, Oregon

*Stick
7950*

Well Record

STATE WELL NO. 36/2w-34B(1)
COUNTY Jackson
APPLICATION NO. GR-438

OWNER: Walter Herzog


MAILING ADDRESS: Route 2, Box 688

LOCATION OF WELL: Owner's No.

CITY AND STATE: Central Point, Oregon

NW 1/4 NE 1/4 Sec. 34 T. 36 N. S., R. 2 E. W., W.M.

Bearing and distance from section or subdivision
corner 652.54' S. & 2981.91' W. from NE cor. DLC 56

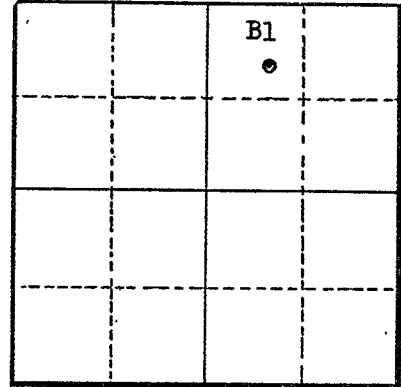

Altitude at well 1215

TYPE OF WELL: Trench Date Constructed 1944

Depth drilled Depth cased

Section 34

CASING RECORD:

FINISH:

AQUIFERS:

WATER LEVEL:

PUMPING EQUIPMENT: Type Centrifugal H.P. 20
Capacity G.P.M.

WELL TESTS:

Drawdown ft. after hours G.P.M.
Drawdown ft. after hours G.P.M.

USE OF WATER Irrigation 25 acres Temp. °F., 19

SOURCE OF INFORMATION GR-438

DRILLER or DIGGER

ADDITIONAL DATA:

Log No Water Level Measurements Chemical Analysis Aquifer Test

REMARKS:

Infiltration trench: 850' long, 10' wide 5 to 12' deep