

STATE ENGINEER
Salem, Oregon

Jack
8015

Well Record

STATE WELL NO. 36/2W-35
COUNTY JACKSON
~~APPLICATION NO.~~ GR-2470

OWNER: Kenneth and Mary J. Mainwaring


MAILING ADDRESS: 5243 Gebhard Rd.,

LOCATION OF WELL: Owner's No. _____

CITY AND STATE: Central Point, Oregon

NE $\frac{1}{4}$ SW $\frac{1}{4}$ SE $\frac{1}{4}$ Sec. 35 T. 36 S., R. 2 W., W.M.

Bearing and distance from section or subdivision corner 1312' N. and 907' E.

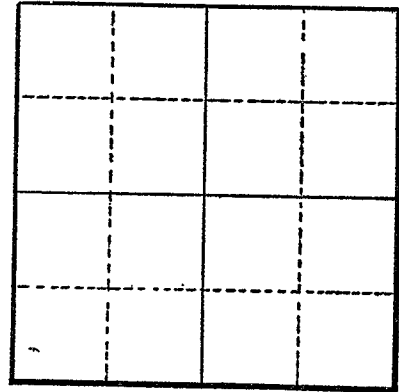

Section _____

Altitude at well _____

TYPE OF WELL: Dug Date Constructed 1955

Depth drilled 20 Depth cased 20

CASING RECORD:

24-inch

FINISH:

5 - 1 1/2" perforations per foot (est) from 14' to 20'

AQUIFERS:

WATER LEVEL:

10-feet

PUMPING EQUIPMENT: Type Berkeley Centrifugal pump H.P. 1
Capacity 30 G.P.M.

WELL TESTS:

Drawdown 2 ft. after _____ hours Pumping 30 G.P.M.
Drawdown _____ ft. after _____ hours _____ G.P.M.

USE OF WATER Irrigation Temp. _____ °F. _____, 19____

SOURCE OF INFORMATION GR-2339

DRILLER or DIGGER Robert Shand - address unknown

ADDITIONAL DATA:

Log _____ Water Level Measurements _____ Chemical Analysis _____ Aquifer Test _____

REMARKS: