

STATE ENGINEER
Salem, Oregon

Salek
8/27

Well Record


STATE WELL NO. 36/2W-36C(1)
COUNTY Jackson
APPLICATION NO. GR-792

OWNER: Rosamend W. Zimmerman MAILING ADDRESS: 5923 Table Rock Rd.

LOCATION OF WELL: Owner's No. #1 CITY AND STATE: Central Point, Oregon

NE 1/4 NW 1/4 Sec. 36 T. 36 S., R. 2 W., W.M.

Bearing and distance from section or subdivision corner 630' S. & 626' W. from the N1/4 corner section 36.

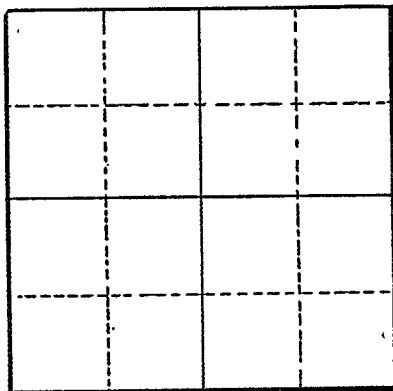

Section 36

Altitude at well 1265 feet

TYPE OF WELL: Dug Date Constructed July 1950

Depth drilled 40 ft. Depth cased None

CASING RECORD:

None

FINISH:

AQUIFERS:

WATER LEVEL:

22 feet

PUMPING EQUIPMENT: Type WH Single phase - Deming cent. 2 in. H.P. 1.5
Capacity 80 G.P.M.

WELL TESTS:

Drawdown 6 ft. after _____ hours 80 G.P.M.
Drawdown _____ ft. after _____ hours _____ G.P.M.

USE OF WATER Irrigation Temp. _____ °F. _____, 19____

SOURCE OF INFORMATION GR-792

DRILLER or DIGGER _____

ADDITIONAL DATA:

Log Yes Water Level Measurements _____ Chemical Analysis _____ Aquifer Test _____

REMARKS:

