

STATE ENGINEER
Salem, Oregon

*Jack
8/29*

Well Record

GR- 1702

STATE WELL NO. 36/2W-36P
COUNTY Jackson
APPLICATION NO. GR-1757

OWNER: Bert J. Marshall


MAILING ADDRESS: 138 Vilas Rd. W.

LOCATION OF WELL: Owner's No. _____

CITY AND STATE: Central Point, Oregon

SE 1/4 SW 1/4 Sec. 36 T. 36 S, R. 2 W., W.M.

Bearing and distance from section or subdivision
corner 265' N. & 740' W. from St cor. Sec. 36

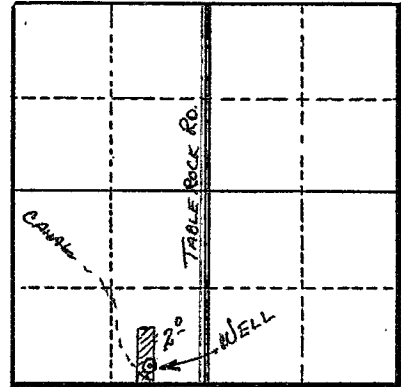

Section 36

Altitude at well 1280'

TYPE OF WELL: Drilled. Date Constructed 1951

Depth drilled 68' Depth cased 60'

CASING RECORD:

6"

FINISH:

AQUIFERS:

WATER LEVEL:

20'

PUMPING EQUIPMENT: Type Wards 1" x 3/4" pressure H.P. 3/4

Capacity 12 G.P.M.

WELL TESTS:

Drawdown _____ ft. after _____ hours _____ G.P.M.

Drawdown _____ ft. after _____ hours _____ G.P.M.

USE OF WATER Irrigation Temp. _____ °F. _____, 19_____

SOURCE OF INFORMATION GR Record

DRILLER or DIGGER _____

ADDITIONAL DATA:

Log N.A. Water Level Measurements _____ Chemical Analysis _____ Aquifer Test _____

REMARKS:

Irrigation of 2 acres.