

STATE ENGINEER  
Salem, Oregon

*Soak  
8/30*

# Well Record

STATE WELL NO. 36/2W-36P  
COUNTY Jackson  
APPLICATION NO. GR-1739

OWNER: Frank B. Haselton


MAILING ADDRESS: Route 1, Box 363

LOCATION OF WELL: Owner's No. \_\_\_\_\_

CITY AND STATE: Central Point, Oregon

SE 1/4 SW 1/4 Sec. 36 T. 36 N. S. R. 2 E. W., W.M.

Bearing and distance from section or subdivision corner 470 feet West and 100 feet North from the SW Corner, Section 36.

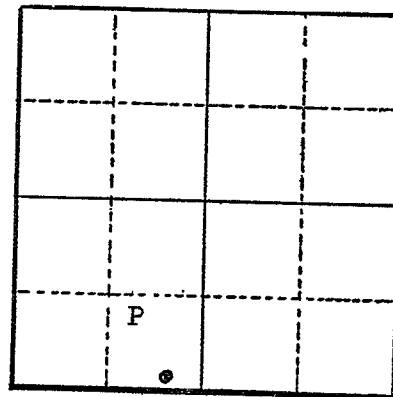

Altitude at well 1300 feet

TYPE OF WELL: Dug Date Constructed 1944

Depth drilled 35 feet Depth cased \_\_\_\_\_

Section 36

CASING RECORD:

FINISH:

AQUIFERS:

WATER LEVEL:

18 feet

PUMPING EQUIPMENT: Type Homant-Jet 1 1/2' - 1 1/2" pipe H.P. \_\_\_\_\_  
Capacity 20 G.P.M.

WELL TESTS:

Drawdown 9 ft. after \_\_\_\_\_ hours 15 G.P.M.

Drawdown \_\_\_\_\_ ft. after \_\_\_\_\_ hours \_\_\_\_\_ G.P.M.

USE OF WATER Pasture Temp. \_\_\_\_\_ °F. \_\_\_\_\_, 19\_\_\_\_

SOURCE OF INFORMATION GR-4047

DRILLER or DIGGER \_\_\_\_\_

ADDITIONAL DATA:

Log (NA) Water Level Measurements \_\_\_\_\_ Chemical Analysis \_\_\_\_\_ Aquifer Test \_\_\_\_\_

REMARKS: