

STATE ENGINEER
Salem, Oregon

Well Record

STATE WELL NO. 36/3W-35H
COUNTY Jackson
APPLICATION NO. GR-3059

OWNER: Janet Lamb (Mrs.)

MAILING
ADDRESS:

Route 1, Box 305


LOCATION OF WELL: Owner's No. _____

CITY AND
STATE:

Central Point, Oregon

SE $\frac{1}{4}$ NE $\frac{1}{4}$ Sec. 35 T. 36 N. S. R. 3 E. W., W.M.

Bearing and distance from section or subdivision
corner 750' N. and 675' W.

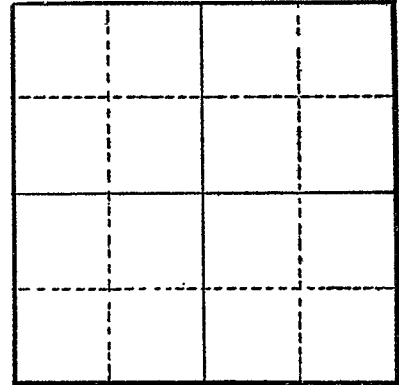

Altitude at well _____

TYPE OF WELL: Drilled Date Constructed 1953

Depth drilled 90' Depth cased 90'

Section _____

CASING RECORD:

6"

FINISH:

AQUIFERS:

WATER LEVEL:

30'

PUMPING EQUIPMENT: Type Pacific 2hp Jet- 1.5" Centrifugal H.P. 2
Capacity 30 G.P.M.

WELL TESTS:

Drawdown _____ ft. after _____ hours _____ G.P.M.
Drawdown _____ ft. after _____ hours _____ G.P.M.

USE OF WATER Irrigation Temp. _____ °F. _____, 19____

SOURCE OF INFORMATION GR-2864

DRILLER or DIGGER Penn Chitwood, Crater Well Drilling, Medford, Oregon

ADDITIONAL DATA:

Log _____ Water Level Measurements _____ Chemical Analysis _____ Aquifer Test _____

REMARKS: