

STATE ENGINEER
Salem, Oregon

JACK
9336
Well Record

STATE WELL NO. 36/3W-36M(2)
COUNTY Jackson
APPLICATION NO. GR-406

OWNER: Dale Vincent

MAILING
ADDRESS:

Route 1, Box 303

LOCATION OF WELL: Owner's No. _____


CITY AND
STATE:

Central Point, Oregon

NW 1/4 SW 1/4 Sec. 36 T. 36 N. 3 E.
S., R. 3 W., W.M.

Bearing and distance from section or subdivision

corner 45' S. & 1245' E. from W 1/4 cor. Sec. 36

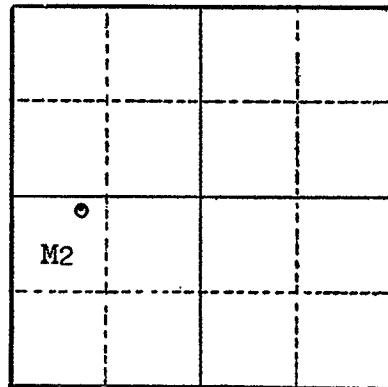

Section 36

Altitude at well 1235

TYPE OF WELL: Drilled Date Constructed July '53

Depth drilled 43 Depth cased 46

CASING RECORD:

8 inch

FINISH:

AQUIFERS:

WATER LEVEL:

6 feet

PUMPING EQUIPMENT: Type 3" jet H.P. 3
Capacity 40 G.P.M.

WELL TESTS:

Drawdown _____ ft. after _____ hours _____ G.P.M.

Drawdown _____ ft. after _____ hours _____ G.P.M.

USE OF WATER Irrigation 2.8 acres Temp. _____ °F. _____, 19____

SOURCE OF INFORMATION GR-406

DRILLER or DIGGER Les Shanahan

ADDITIONAL DATA:

Log No Water Level Measurements _____ Chemical Analysis _____ Aquifer Test _____

REMARKS: