

STATE ENGINEER
Salem, Oregon

5A2
9338 Well Record

STATE WELL NO. 36/3W-36M(1)
COUNTY Jackson
APPLICATION NO. GR-406

OWNER: Dale Vincent MAILING ADDRESS: Route 1, Box 303

LOCATION OF WELL: Owner's No. #1 sump CITY AND STATE: Central Point, Oregon


NW 1/4 SW 1/4 Sec. 36 T. 36 N. S. R. 36 E. W. W.M.

Bearing and distance from section or subdivision
corner 65' S. & 600' E. from W 1/4 cor. Sec. 36

Altitude at well 1235

TYPE OF WELL: Dug Date Constructed Sept. '51

Depth drilled 5.5 Depth cased none

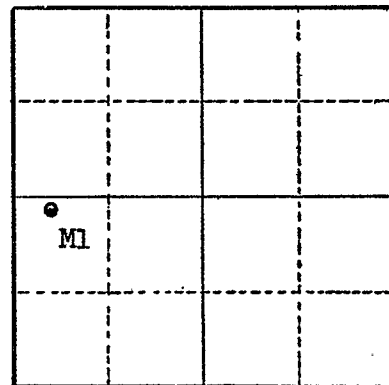

Section 36

CASING RECORD:

none

FINISH:

AQUIFERS:

WATER LEVEL:

2 feet

PUMPING EQUIPMENT: Type 3" centrifugal H.P. 15
Capacity 200 G.P.M.

WELL TESTS:

Drawdown ft. after hours G.P.M.
Drawdown ft. after hours G.P.M.

USE OF WATER Irrigation 3.4 acres Temp. °F., 19
SOURCE OF INFORMATION GR-406

DRILLER or DIGGER

ADDITIONAL DATA:

Log no Water Level Measurements Chemical Analysis Aquifer Test

REMARKS:

Infiltration trench: 16' long, 8' wide, 5 to 5.5' deep