

STATE ENGINEER
Salem, Oregon

Jack
9486 Well Record

STATE WELL NO. 36/4W-3M(1)
COUNTY Jackson
APPLICATION NO. GR-567

OWNER: L. L. Bennett


MAILING ADDRESS: Route 1, Box 27

LOCATION OF WELL: Owner's No. _____

CITY AND STATE: Rogue River, Oregon

NW $\frac{1}{4}$ SW $\frac{1}{4}$ Sec. 3 T. 36 ^{N.} S., R. 4 ^{E.} W., W.M.

Bearing and distance from section or subdivision corner 265' S. & 875' E. from W $\frac{1}{4}$ cor. Sec. 3

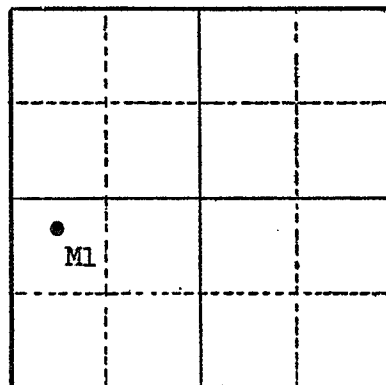

Section 3

Altitude at well 1100

TYPE OF WELL: Dug Date Constructed 1936

Depth drilled 24 Depth cased _____

CASING RECORD:

50' x 80' pit

FINISH:

AQUIFERS:

WATER LEVEL:

6'

PUMPING EQUIPMENT: Type centrifugal H.P. 9

Capacity 15 G.P.M.

WELL TESTS:

Drawdown _____ ft. after _____ hours _____ G.P.M.

Drawdown _____ ft. after _____ hours _____ G.P.M.

USE OF WATER Irrigation 17 acres Temp. _____ °F. _____, 19____

SOURCE OF INFORMATION GR-567

DRILLER or DIGGER _____

ADDITIONAL DATA:

Log _____ Water Level Measurements _____ Chemical Analysis _____ Aquifer Test _____

REMARKS: