

New exempt use wells must be submitted with a map and recording fee.

WATER SUPPLY WELL REPORT - Map with location identified must be attached and shall include an approximate scale and north arrow

JEFF 51859

7/30/2026

Map of Hole

STATE OF OREGON WELL LOCATION MAP

This map is supplemental to the WATER SUPPLY WELL REPORT

Oregon Water Resources Department

725 Summer St NE, Salem OR 97301
(503)986-0900



LOCATION OF WELL

Latitude: 44.40421606 Datum: WGS84

Longitude: -121.26952729

Township/Range/Section/Quarter-Quarter Section:
WM13.00S12.00E35NWNW

Address of Well:


6947 SW ERMINE RD, TERREBONNE, OR 97760

Well Label: 41061

Printed: July 30, 2026

DISCLAIMER: This map is intended to represent the approximate location the well. It is not intended to be construed as survey accurate in any manner.

Provided by well constructor

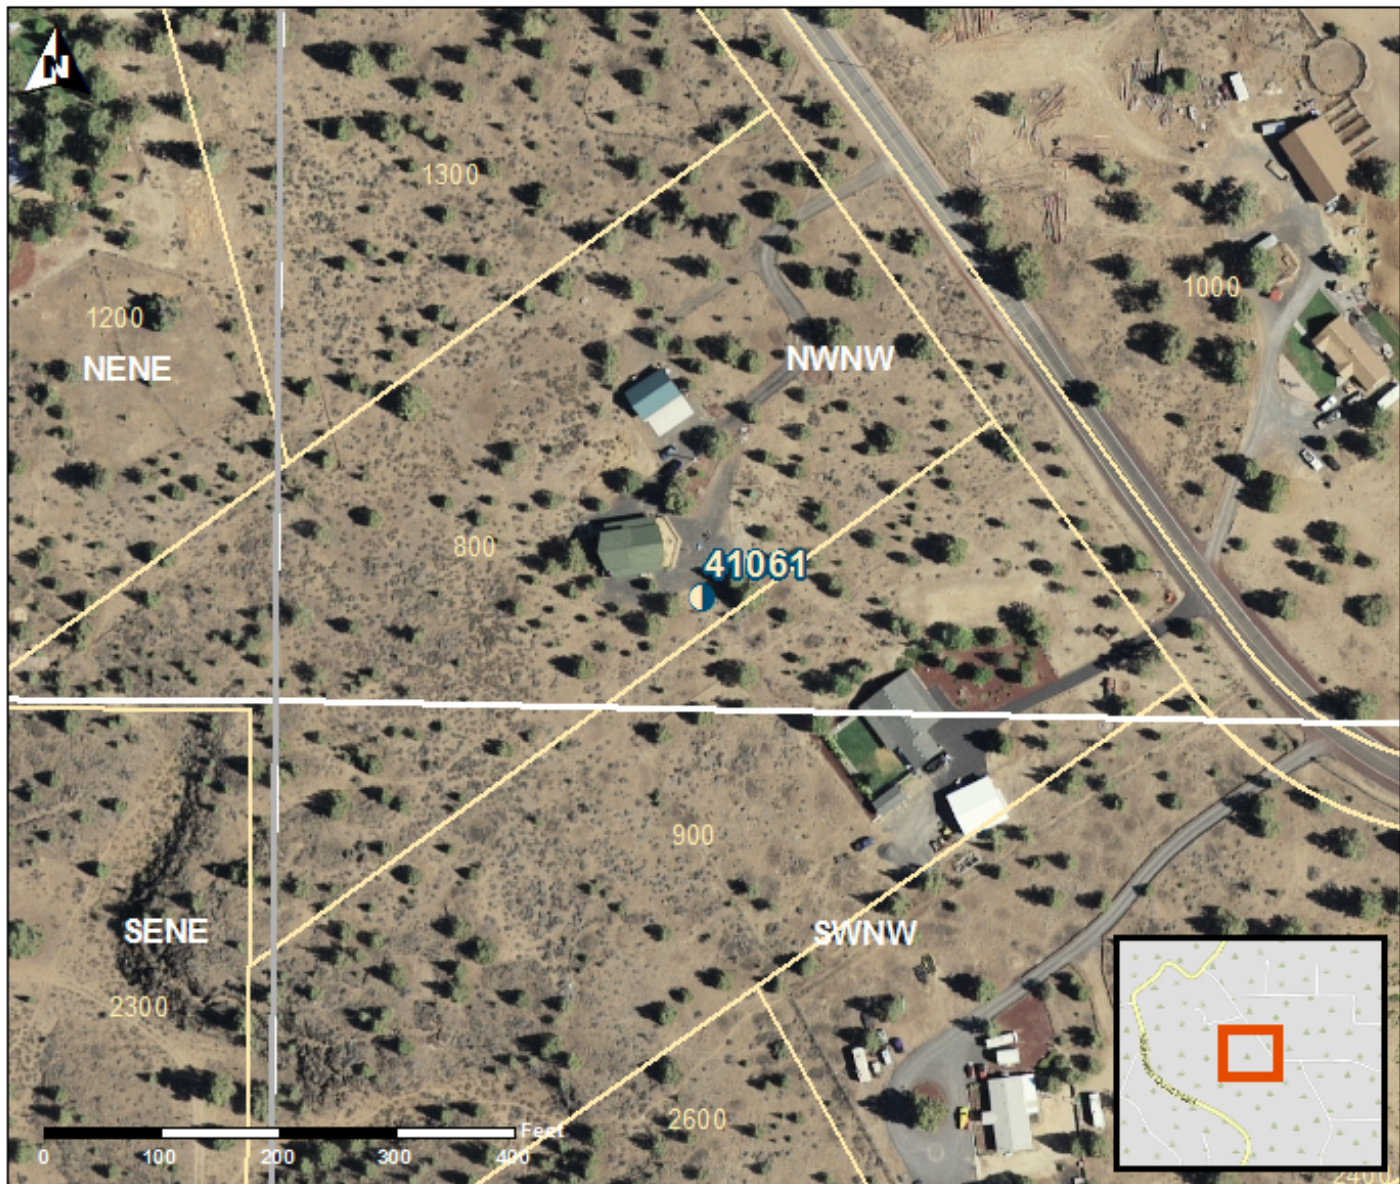

7/30/2026

Map of Hole

