


WATER SUPPLY WELL REPORT - Map with location identified must be attached and shall include an approximate scale and north arrow

JEFF 51860

9/10/2026

Map of Hole

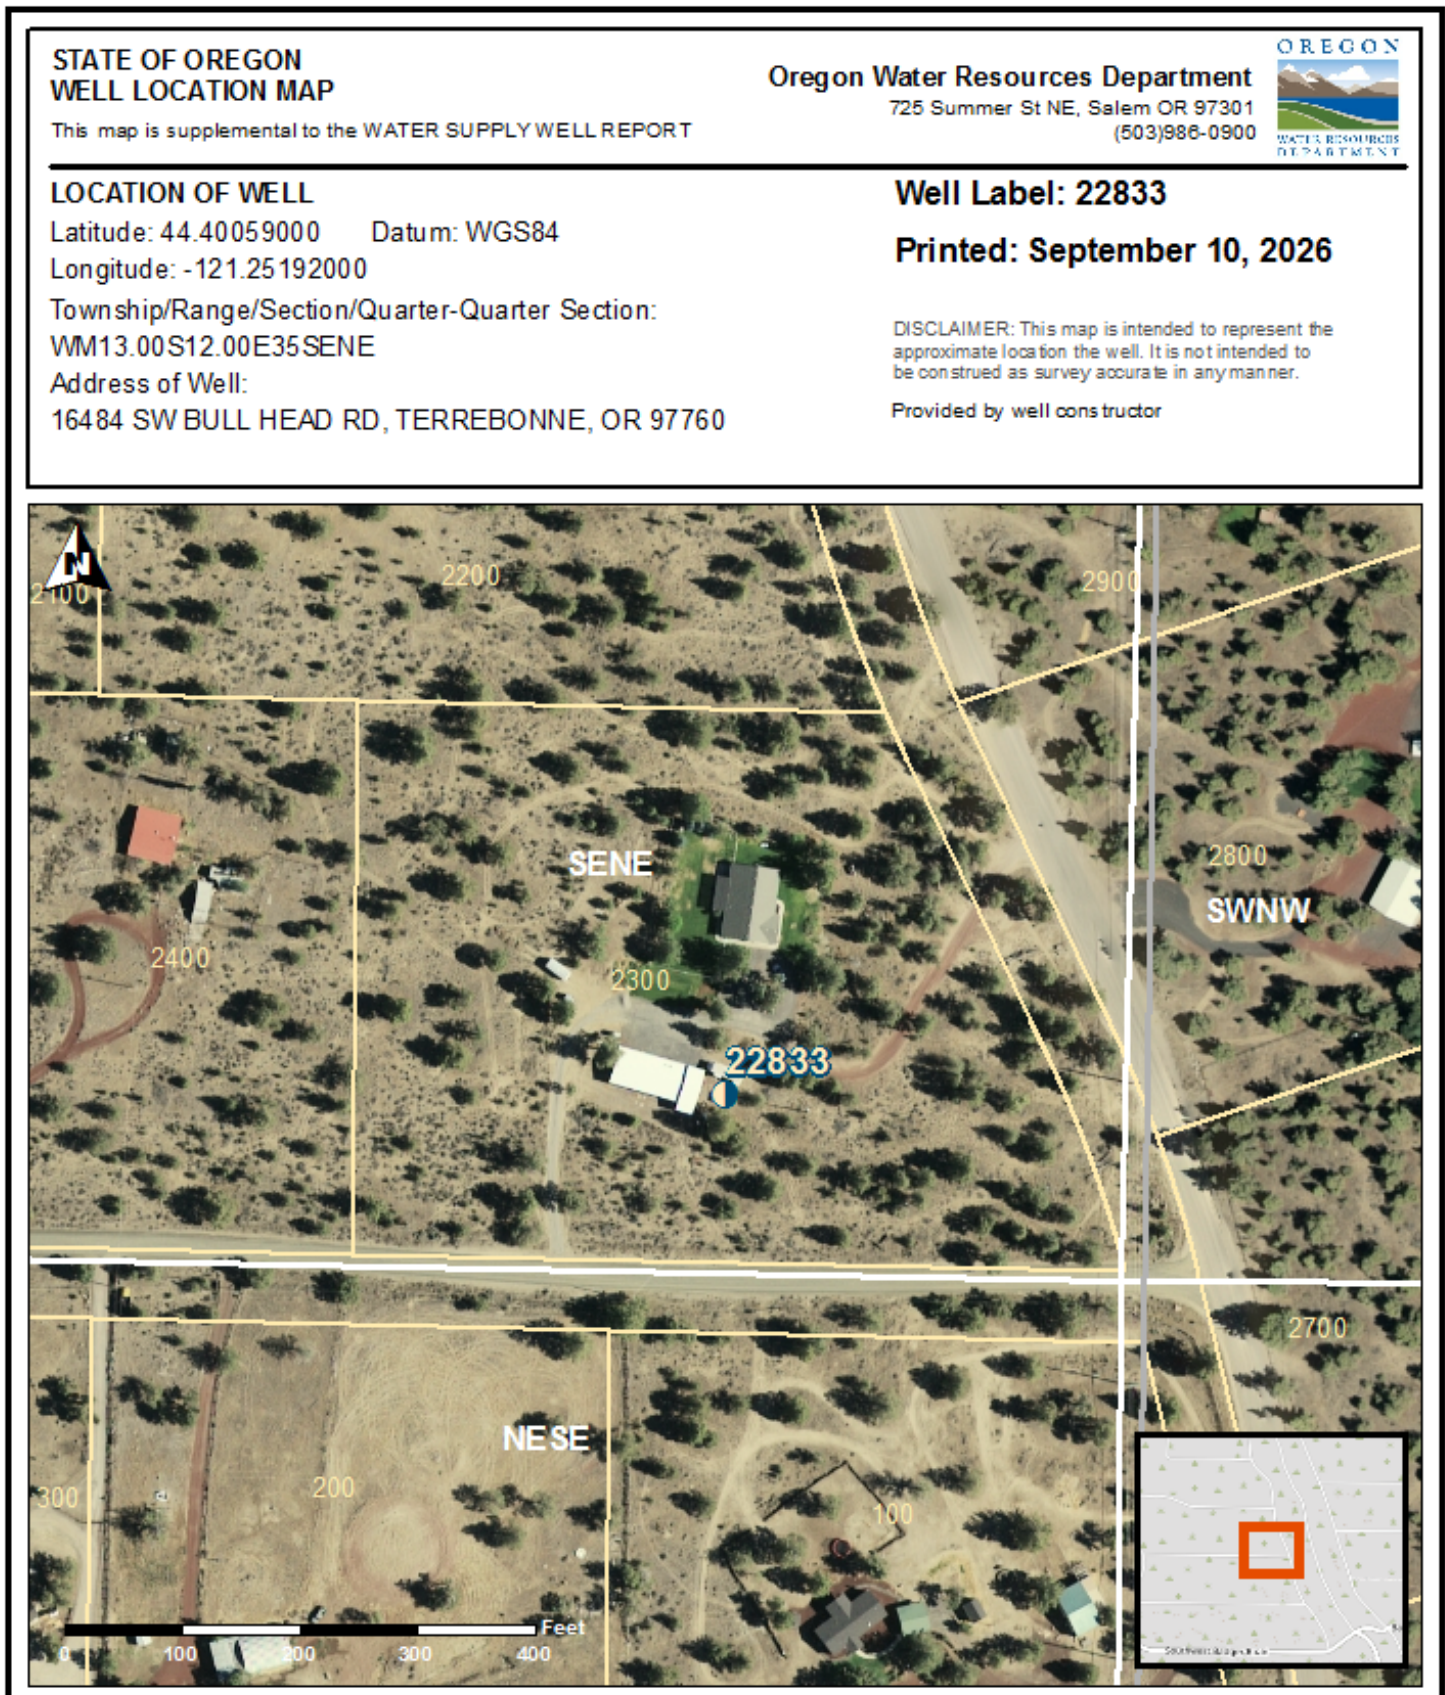

9/10/2026

Map of Hole

