

JEFF
659

Well Record

OWNER: Crooked River Ranch MAILING ADDRESS:

LOCATION OF WELL: Owner's No. CITY AND STATE:


1/4 1/4 Sec. T. N. E. S, R. W., W.M.

Bearing and distance from section or subdivision corner

Altitude at well

TYPE OF WELL: Drilled. Date Constructed

Depth drilled ? Depth cased

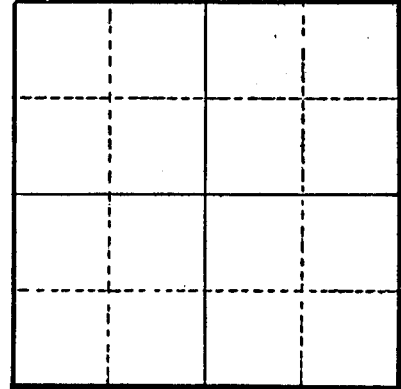

Section

CASING RECORD:

12 inch

FINISH:

AQUIFERS:

WATER LEVEL:

282 feet

PUMPING EQUIPMENT: Type H.P. Capacity G.P.M.

WELL TESTS:

Drawdown 2 ft. after hours pumping 2,500 G.P.M.
Drawdown ft. after hours G.P.M.

USE OF WATER Irrigation Temp. °F., 19

SOURCE OF INFORMATION

DRILLER or DIGGER R. J. Strasser

ADDITIONAL DATA:

Log Water Level Measurements Chemical Analysis Aquifer Test

REMARKS: