

STATE ENGINEER
Salem, Oregon

JEFF
832

Well Record

STATE WELL NO. 13/12-14G1
COUNTY Jefferson
APPLICATION NO.

OWNER: Crooked River Ranch

MAILING
ADDRESS:


LOCATION OF WELL: Owner's No.

CITY AND
STATE:

Terrebonne, Oregon

SW 1/4 NE 1/4 Sec. 14 T. 13 N. S., R. 12 E. W., W.M.

Bearing and distance from section or subdivision
corner

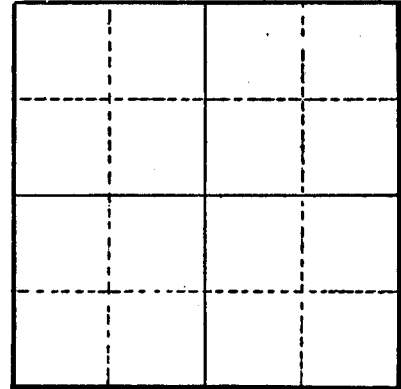

Section

Altitude at well

TYPE OF WELL: Drilled Date Constructed 1944

Depth drilled 280 Depth cased

CASING RECORD:

16 inch

FINISH:

AQUIFERS:

WATER LEVEL:

PUMPING EQUIPMENT: Type H.P.
Capacity G.P.M.

WELL TESTS:

Drawdown ft. after hours G.P.M.

Drawdown ft. after hours G.P.M.

USE OF WATER Temp. °F., 19

SOURCE OF INFORMATION U-286

DRILLER or DIGGER

ADDITIONAL DATA:

Log Water Level Measurements Chemical Analysis Aquifer Test

REMARKS:

St. Engr

13/12-14F

OREGON STATE BOARD OF HEALTH

RECEIVED
DEC 8 1965

Mineral Content of Water

STATE ENGINEER
SALEM, OREGON

Name of Water Supply George Bell

Source Spring

Sampling Point Catchment box at pump intake

Collected By J. E. Scova and W. S. Bartholomew Date 11-3-65

Analysis By A. W. Rose Date 11-17-65

Laboratory Number 0961

	<u>Mg/L</u>		<u>Mg/L</u>
Color	2	Conductance (mc mho/cm)	186
Turbidity	2.5	Chlorides	6.2
Solids, Total	156	Sodium	18.4
Solids, Volatile	55	Potassium	2.5
Carbon Dioxide	4.7	Fluoride	0.31
pH	7.5	Phosphates	0.33
Alkalinity, Total as CaCO ₃	81	Sulfates	4.5
Hardness as CaCO ₃	63.6	Silicon	38
Calcium	9.5	Aluminum	0.02
Magnesium	9.7	Nitrogen, Ammonia	0.19
Iron	0.02	Nitrogen, Nitrite	0.01
Manganese	0.05	Nitrogen, Nitrate	0.25
Arsenic	0.005		

REMARKS _____
