

STATE ENGINEER
Salem, Oregon

Joe
15025

Well Record

STATE WELL NO. 39/5W-6K(2)
COUNTY Josephine
APPLICATION NO. GR-90

OWNER: Brown Bros. Lumber Co. Inc.


MAILING ADDRESS: _____

LOCATION OF WELL: Owner's No. #2

CITY AND STATE: Grants Pass, Oregon

NW 1/4 SE 1/4 Sec. 6 T. 39 S., R. 5 W., W.M.

Bearing and distance from section or subdivision corner N 70° W 660' to center of Sec. 6

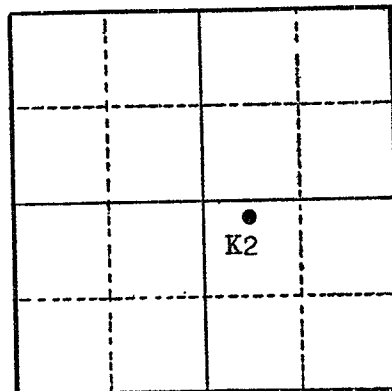

Altitude at well 1700' Interpolated

TYPE OF WELL: Drilled Date Constructed 5/15/52

Depth drilled 209' Depth cased 209'

Section 6

CASING RECORD:

8 inch casing set from 0 to 209 feet

FINISH:

42 perforations 3/16 x 3" set from 43 to 65'
51 perforations " " set from 84 to 120'
83 perforations " " set from 174 to 206'

AQUIFERS:

WATER LEVEL:

Rock from 84' to 209'

PUMPING EQUIPMENT: Type Pacific Busford Submersible H.P. 4
Capacity 28 G.P.M.

WELL TESTS:

Drawdown 175 ft. after _____ hours 24 G.P.M.
Drawdown _____ ft. after _____ hours _____ G.P.M.

USE OF WATER Industrial (Lumber Mill) Temp. _____ °F. _____, 19_____

SOURCE OF INFORMATION Registration Statement GR-90

DRILLER or DIGGER Paquin & Story Grants Pass, Oregon

ADDITIONAL DATA:

Log Water Level Measurements _____ Chemical Analysis _____ Aquifer Test _____

REMARKS:

