

JOSE 15827

OBSERVATION WELL

Well Record

STATE ENGINEER  
Salem, Oregon

*Jose*  
*15827*


STATE WELL NO. 39/5W-6K(1) ✓  
COUNTY Josephine  
APPLICATION NO. GR-90

OWNER: Brown Bros. Lumber Co. Inc. MAILING ADDRESS:

LOCATION OF WELL: Owner's No. #1 CITY AND STATE: Grants Pass, Oregon

NW 1/4 SE 1/4 Sec. 6 T. 39 N. S., R. 5 E. W., W.M.

Bearing and distance from section or subdivision corner N 54° 30' W 450' to center of Sec. 6

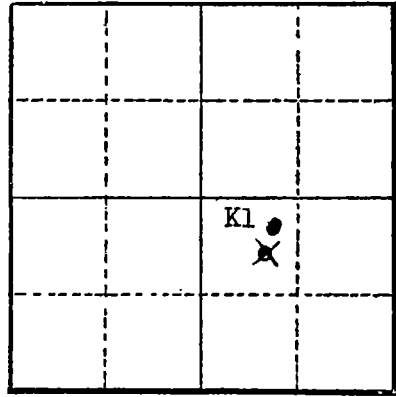

Section 6

Altitude at well 1695' Interpolated

TYPE OF WELL: Drilled Date Constructed 6/1/52

Depth drilled 170' Depth cased 43'

CASING RECORD:

12 inch casing set from 0 to 43'  
8 inch casing set from 0 to 76'

FINISH:

58 perforations 3/16" x 4" set from 43 to 73 feet

AQUIFERS:

Rock (blue? granite) from 76 to 170'

WATER LEVEL:

31 feet below land surface 6/18/52

PUMPING EQUIPMENT: Type Doward Jet H.P. 1 1/2  
Capacity 20 G.P.M.

WELL TESTS:

Drawdown 80' ft. after 18 hours G.P.M.  
Drawdown ft. after hours G.P.M.

USE OF WATER Industrial (Lumber Mill) Temp. °F. 19

SOURCE OF INFORMATION Registration Statement GR-90

DRILLER or DIGGER Paquin & Story 657 Highway 99S Grants Pass, Oregon

ADDITIONAL DATA:

Log X Water Level Measurements Chemical Analysis Aquifer Test

REMARKS:

