

9809C 3/8



JOSEPHINE COUNTY OREGON

WATER RESOURCES DEPARTMENT

APPLICATION FOR WELL PERMIT

Start Card No. 35446

Well Permit No. **7837**

RECEIVED

JUN 18 1993

WATER RESOURCES DEPT.
SALEM, OREGON

Permit Requested: New. X Repair/Alter.... Abandon.... Replacement....

Use of Well: Domestic, S Domestic, M.... Irrigation.... Institutional.....
Thermal.... Commercial/Industrial.... Other.....

Property Owner: Darryl & Terry Dickerson..... Phone:.....

Mailing Address: 155 Three Pines.....

Description of Property: Township 35.. Range 6.. Section 3.... Tax Lot 500

Address of Property: 466 Three Pines.....

Well (to be) (is) Located: 890 ft. South, 480 ft. East, from N 1/4 Corner
of Section 3..... in NW 1/4 NE 1/4

Proposed Constructor: Ed's.....

Date of Construction, Repair/Alteration, Abandonment: 5-25-93


Applicant's Signature: Ken phoned @ 0800..... Date: 5-20-93

Permit Issued By: Chante..... Fee?..... Date: 5-20-93

This permit is valid for six (6) months from date issued.

This permit does not invalidate any local, state, or federal restrictions.

REMARKS: SCALE OF MAP: 1" = 480' MAP #: 35-6-3

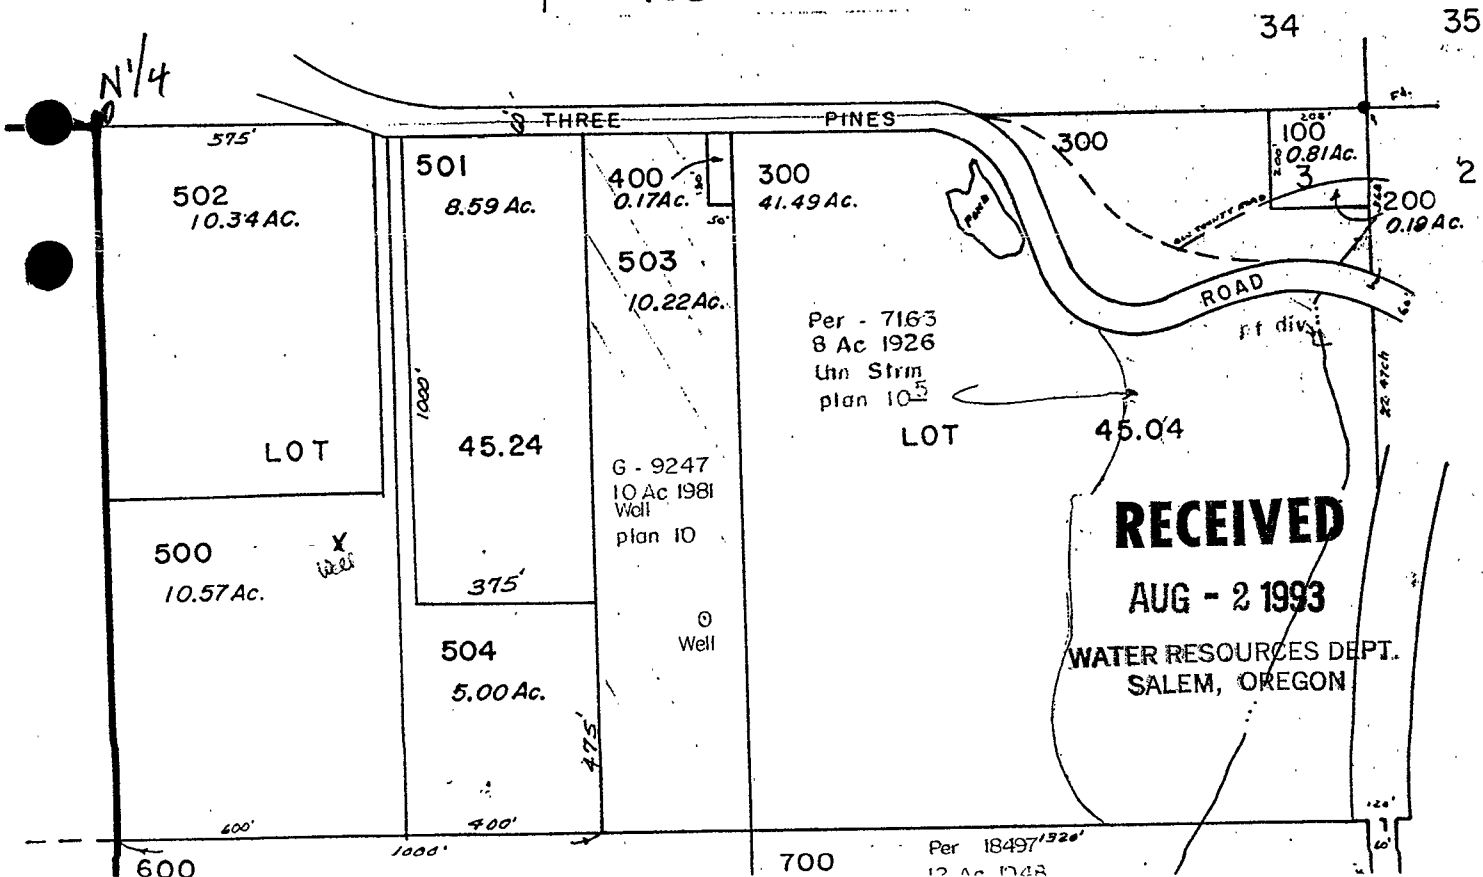

CANCEL

350
409
600
601
369
100
THI
33
34
34
34
35
36
TH
36

SEE MAP 35 6 2B