



Oregon Water Resources Department
725 Summer Street NE, Suite A
Salem Oregon 97301
(503) 986-0900
www.oregon.gov/owrd

Application for Well ID Number

RECEIVED

Do not complete if the well already has a Well Identification Number.

JAN 31 2020

I. OWNER INFORMATION

OWRD

Current Owner Name (please print): Joe Gerlach

Mailing Address: 6380 Tunnel Loop Rd.

City, State, Zip: Grants Pass, OR, 97527

Mail Well ID to: ☐ SAME AS ABOVE ☐ In Care Of (C/O)

Name & Address:

City, State, Zip:

II. WELL LOCATION INFORMATION (Please fill out as completely as possible)

Township: 34 S (North / South) Range: 6 W (East / West) Section: 28 SE 1/4 of the NW 1/4

Tax Lot (usually last 3-5 numbers of Tax Map #): 500

County Josephine

GPS Coordinates: 42.58835, -123.41968

Street Address of Well, City: 6250 Tunnel Loop Road, Grants Pass, OR 97526

If the property had a different street address in the past:

III. GENERAL WELL INFORMATION (Please fill out as completely as possible, AND attach copy of Well Report, if available)

Use of Well (domestic, irrigation, commercial, industrial, monitoring):

Date Well Constructed (or property built): 11/18/1993 Total Well Depth: 550' Casing Diameter: 6"

Owner at time the well was constructed (if known): Jou & Judy Petralli Well Report # (if known): JOSE 16821

Other Information: Identified as Well 3 on the permit map for G-17944

SUBMITTED BY (please print): Scott Ceciliani - District 14 Watermaster (Well ID placed by -)

PHONE: 541-261-2213

EMAIL &/or FAX: scott.c.ceciliani@oregon.gov

Send application to: Oregon Water Resources Department 725 Summer St NE, Suite A, Salem, Oregon 97301; or fax to (503) 986-0902.
Applications are processed in the order they are received, and Well ID Numbers are mailed within 4-5 business days.

For Official Use Only by the Oregon Water Resources Department:

Received Date:

1-31-2020


Well Report Number:

JOSE 16821

Well Identification #:

L-129930

T34S R6W South Half Northwest Quarter and North Half Southwest Quarter Section 28

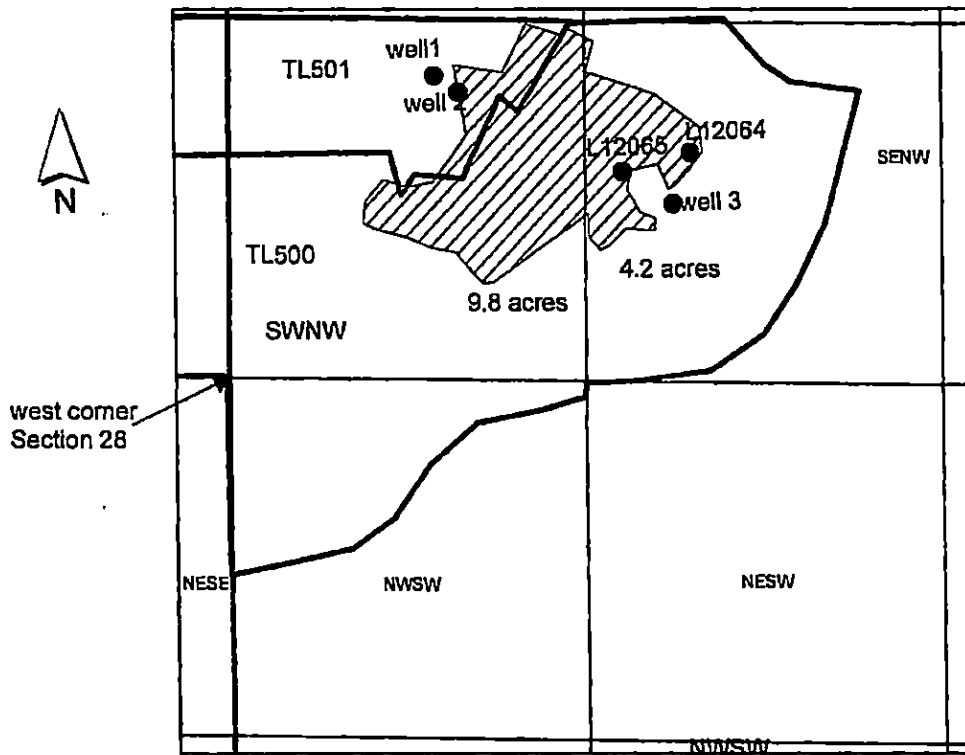

1 inch = 660 feet

Well 1 is located approximately 766 ft ^{east} west and 1118 ft north of the west corner of Section 28.

Well 2 is located approximately 861 ft ^{east} west and 1047 ft north of the west corner of Section 28.

Well 3 is located approximately 1665 ft ^{east} west and 616 ft north of the west corner of Section 28.

Well L12065 is located approximately 1479 ft ^{east} west and 791 ft north of the west corner of Section 28.

Well L12064 is located approximately 1731 ft ^{east} west and 816 ft north of the west corner of Section 28.

RECEIVED BY OWRD

JAN 23 2017

SALEM, OR

G-18423