
NOTICE TO WATER WELL CONTHATO The original and first copy of this report are to be SEP 16 1970 FATE OF OREGON STATE ENGINEER, SALEM, OREGON 97616 ENCINED and write above this line) of well completion. State

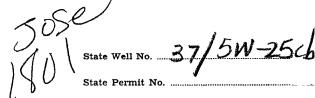

	V			
(1) OWNER: Name Thomas C Schultz	(11) LOCATION OF WELL: County Tose phine Driller's well n	umber	#10)
Address / 2100 N. APPLEGATE Rd. GVANTS PASS, ore.	NW 1/4 5 NV 1/4 Section 25 T. 3		5 Wes	7 W.M.
(2) TYPE OF WORK (check):	Bearing and distance from section or subdivision corner 50 FT			
New Well Deepening □ Reconditioning □ Abandon □	From SE Corner			
If abandonment, describe material and procedure in Item 12.		· · · · · · · · · · · · · · · · · · ·		
(3) TYPE OF WELL: (4) PROPOSED USE (check):	(40) 77777 7 00			, ,,
Rotary Driven Demostia Ranductula Recording	(12) WELL LOG: Diameter of well		•	• -
Cable 2 Jetted Domestic 2 Industrial Municipal Dug Bored Irrigation Test Well Other	Depth drilled 6.5 ft. Depth of comp			5 ft.
CASING INSTALLED: Threaded Welded Manual Diam. fromtt. to	Formation: Describe color, texture, grain size and show thickness and nature of each strate with at least one entry for each change of for in position of Static Water Level as drilling pr	ım and a nation. R	quifer pe eport eac	enetrated, th change
" Diam. fromft. toft. Gage	MATERIAL	From	То	SWL
"Diam. fromft. toft. Gage	Small boulders	Ö	6	
PERFORATIONS: Perforated? V Yes No.	Chart Brown gravite	6	27	
Type of perforator used GAS	Grev GrANITE	27	48	
Size of perforations 1/4 in. by 4/4 in.	Gravet + Grey Granite	48	6/	28
52 perforations from 78 tt. to 63 tt.	Gray GrANITE	61	65	28
perforations fromft. toft.		 		
perforations fromft. toft.				
perforations from ft. to ft.				<u> </u>
perforations fromft. toft.				
(7) SCREENS: Well screen installed? Yes No				
Manufacturer's Name				
TypeModel No.		-		· · · · · · · · · · · · · · · · · · ·
Diam. Slot size Set from ft. to ft.	:	 	_	
Diam. Slot size Set from ft. to ft.	7.7		 	
(8) WATER LEVEL: Completed well.				-
Static level 28 ft. below land surface Date 8-19-70				
esian pressure lbs. per square inch Date				
(9) WELL TESTS: Drawdown is amount water level is				
lowered below static level				
Was a pump test made? Yes 17 No If yes, by whom?	Work started 8-17 1978 Comple	ted 🗫	-19	19 70
Yield: gal./min. with ft. drawdown after hrs.	Date well drilling machine moved off of well	8-1		1970
		<u></u>	,	
	Drilling Machine Operator's Certification: This well, was constructed under my d	irect sur	ervision	Mate-
Bailer test 8 /2 gal./min. with 20 ft. drawdown after / hrs.	rials used and information reported abo			
Artesian flow g.p.m. Date	knowledge and belief.	q	111	م ويت
Temperature of water Was a chemical analysis made? Yes No	[Signed] John J. Bunting (Drilling Machine Operator)	Date 1.	- !1	., 19.7.0
(10) CONSTRUCTION:	Drilling Machine Operator's License No.	394	/	
Well seal-Material used BCNTONITE				
Diameter of well bore to bottom of seal / / in	Water Well Contractor's Certification:			
	This well was drilled under my jurisdiction and this report is true to the best of my knowledge and belief.			
Were any loose strata cemented off? ☐ Yes No Depth	NAME John J. Bunting well Drilling (Person, firm or corporation) (Type or print)			
Did any strata contain unusable water? Yes No		(Typ	e or print)	
Type of water? depth of strata	Address 4350 Jerome Prairiety	LLTAN	115 MA	ss, o re
	O. L. O. B. t.	1		
Method of sealing strata off	[Signed] John Guller Well Confer	(tor)		***********
Was well gravel packed? Yes No Size of gravel:	En =	9-14	,	וע 17
Gravel placed from ft. to ft.	Contractor's License No. 5.30 Date	1-11	,	19