

STATE ENGINEER  
Salem, Oregon


Jose  
18031

# Well Record

STATE WELL NO. 33/6W-15P  
COUNTY Josephine  
APPLICATION NO. GR-4119

OWNER: Trufir Lumber Company MAILING ADDRESS: P.O. Box 216  
LOCATION OF WELL: Owner's No. CITY AND STATE: Wolf Creek, Oregon

SE  $\frac{1}{4}$  SW  $\frac{1}{4}$  Sec. 15 T. 33 S., R. 6 W., W.M.  
Bearing and distance from section or subdivision  
corner 500' N. & 180' W. from S $\frac{1}{4}$  Cor. Sec. 15

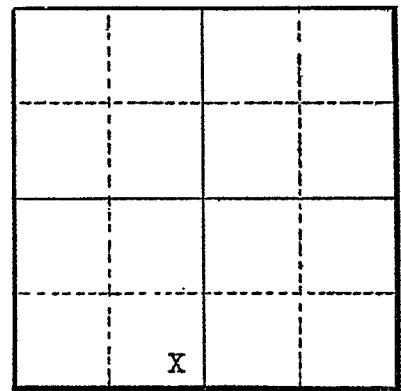

Altitude at well \_\_\_\_\_

TYPE OF WELL: \_\_\_\_\_ Date Constructed 1953  
Depth drilled 75 ft. Depth cased 75 ft.

Section 15

### CASING RECORD:

8 5/8 inch casing set to 75 feet

### FINISH:

perforated from 30 to 75 feet

### AQUIFERS:

### WATER LEVEL:

PUMPING EQUIPMENT: Type Installed temporary H.P. 30  
Capacity \_\_\_\_\_ G.P.M.

### WELL TESTS:

Drawdown \_\_\_\_\_ ft. after \_\_\_\_\_ hours \_\_\_\_\_ G.P.M.  
Drawdown \_\_\_\_\_ ft. after \_\_\_\_\_ hours \_\_\_\_\_ G.P.M.

USE OF WATER Manufacturing Temp. \_\_\_\_\_ °F., 19 \_\_\_\_\_

SOURCE OF INFORMATION Well Registration Statement Cert. # GR-3702

DRILLER or DIGGER Colman Well Drilling

### ADDITIONAL DATA:

Log  Water Level Measurements \_\_\_\_\_ Chemical Analysis \_\_\_\_\_ Aquifer Test \_\_\_\_\_

### REMARKS:

Log:  
Clay with flat rock