

STATE ENGINEER  
Salem, Oregon

JOSE  
1805

# Well Record

STATE WELL NO. 34/6W-9A(1)  
COUNTY Josephine  
APPLICATION NO. GR-158

OWNER: John M. Biencourt

MAILING ADDRESS:


LOCATION OF WELL: Owner's No. 1

CITY AND STATE:

Sunny Valley, Oregon

NE 1/4 NE 1/4 Sec. 9 T. 34 S., R. 6 W., W.M.

Bearing and distance from section or subdivision  
corner 300' S. & 200' W. from NE cor. Sec. 9

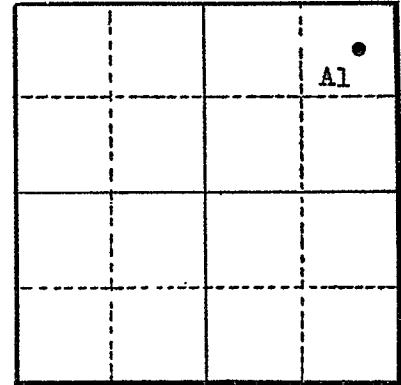

Altitude at well 1170' Interpolated

TYPE OF WELL: Pit Dug Date Constructed 12/45

Depth drilled 15' Depth cased none

Section 9

### CASING RECORD:

None

### FINISH:

None

### AQUIFERS:

Gravels 0 to 15'

### WATER LEVEL:

10 feet below land surface Sept. 1946

PUMPING EQUIPMENT: Type 4" centrifugal H.P. 10

Capacity 600 G.P.M.

### WELL TESTS:

Drawdown ..... ft. after ..... hours ..... G.P.M.

Drawdown ..... ft. after ..... hours ..... G.P.M.

USE OF WATER Irrigation 80 acres Temp. °F. ...., 19

SOURCE OF INFORMATION Registration Statement GR-158

DRILLER or DIGGER

### ADDITIONAL DATA:

Log No Water Level Measurements ..... Chemical Analysis ..... Aquifer Test .....

### REMARKS: