

STATE ENGINEER
Salem, Oregon

Well Record

STATE WELL NO. 35/6W-23F
COUNTY JOSEPHINE
APPLICATION NO. GR-2343

OWNER: Wilbur D. Cullison

MAILING
ADDRESS:

Rt. 1, Box 895

LOCATION OF WELL: Owner's No.


CITY AND
STATE:

Grants Pass, Oregon

SE 1/4 NW 1/4 Sec. 23 T. 35 N. S. R. 6 E. W.M.

Bearing and distance from section or subdivision

corner Highway 99 North of Grants Pass

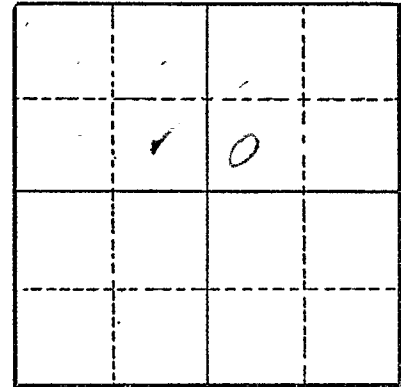

Section

Altitude at well

TYPE OF WELL: Dug Date Constructed 1920

Depth drilled 35 Depth cased

CASING RECORD:

FINISH:

AQUIFERS:

Rock and clay

WATER LEVEL:

2-feet

PUMPING EQUIPMENT: Type Centrifugal

H.P. 5

Capacity 250 G.P.M.

WELL TESTS:

Drawdown 25 ft. after hours Pumping 100 G.P.M.

Drawdown ft. after hours G.P.M.

USE OF WATER Irrigation

Temp. °F. 19

SOURCE OF INFORMATION

GR-2227

DRILLER or DIGGER

ADDITIONAL DATA:

Log X Water Level Measurements Chemical Analysis Aquifer Test

REMARKS:

Rock and clay

Granite and shale (water bearing)

Clay

2 or 3' & 3'

20 to 3' about 30'

5' 35'