

STATE ENGINEER  
Salem, Oregon


*JOSE  
19079*

# Well Record

STATE WELL NO. 35/6W-23D  
COUNTY Josephine  
APPLICATION NO. GR-3956 ✓

OWNER: James Arthur Vaus, Jr. MAILING ADDRESS: Route 1, Box 905  
CITY AND STATE: Grants Pass, Oregon

LOCATION OF WELL: Owner's No. \_\_\_\_\_  
N. E.  
NW 1/4 NW 1/4 Sec. 23 T. 35 S., R. 6 W., W.M.  
Bearing and distance from section or subdivision  
corner 1000' (approx.) from NE Cor. Sec. 23

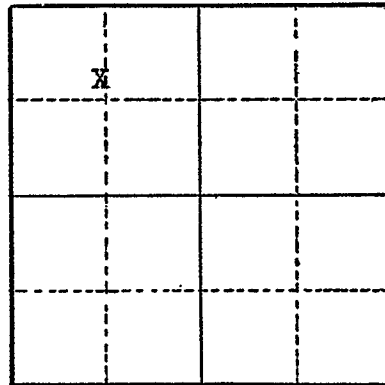

Section 23

Altitude at well \_\_\_\_\_

TYPE OF WELL: Drilled Date Constructed 8/16/51  
Depth drilled 170 ft. Depth cased 140 ft.

### CASING RECORD:

8 5/8 od. inch standard casing from surface to 140 feet

### FINISH:

30 per foot 1/2" x 3" slots from 40 to 140 feet

### AQUIFERS:

### WATER LEVEL:

40 feet below surface

PUMPING EQUIPMENT: Type Berkeley H.P. 7 1/2  
Capacity 25 G.P.M.

### WELL TESTS:

Drawdown 40 ft. after \_\_\_\_\_ hours 25 G.P.M.  
Drawdown \_\_\_\_\_ ft. after \_\_\_\_\_ hours \_\_\_\_\_ G.P.M.

USE OF WATER Irrigation Temp. \_\_\_\_\_ °F. \_\_\_\_\_, 19\_\_\_\_\_

SOURCE OF INFORMATION Well Registration Statement Cert. # GR-3742

DRILLER or DIGGER Colemans's Well Drilling

### ADDITIONAL DATA:

Log X Water Level Measurements \_\_\_\_\_ Chemical Analysis \_\_\_\_\_ Aquifer Test \_\_\_\_\_

### REMARKS:

Log:  
Decomposed granite top to bottom  
Various strata 40' to bottom