

STATE ENGINEER  
Salem, Oregon

*Joe*  
*7/8/06*

# Well Record

STATE WELL NO. 35/6W-21G  
COUNTY Josephine  
APPLICATION NO. GR-3520 ✓

OWNER: Bate Lumber Company


MAILING ADDRESS: Merlin

LOCATION OF WELL: Owner's No. Well #3

CITY AND STATE: Oregon

SW  $\frac{1}{4}$  SW  $\frac{1}{4}$  NE  $\frac{1}{4}$  Sec. 21 T. 35 S., R. 6 W., W.M.

Bearing and distance from section or subdivision corner 325' E. 2° N from center Sec. 21

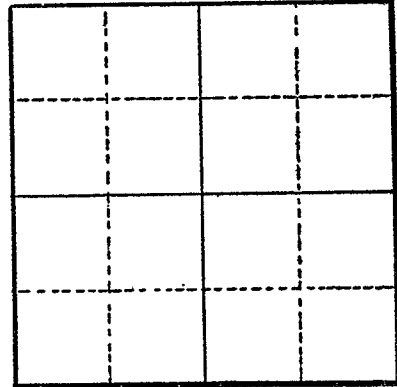

Section .....

Altitude at well .....

TYPE OF WELL: drilled Date Constructed prior 1952

Depth drilled 94' Depth cased 94'

CASING RECORD:

6"

FINISH:

AQUIFERS:

WATER LEVEL:

PUMPING EQUIPMENT: Type Myers Jet Pump H.P. 1  
Capacity 15 G.P.M.

WELL TESTS:  
Drawdown ..... ft. after ..... hours ..... G.P.M.  
Drawdown ..... ft. after ..... hours ..... G.P.M.

USE OF WATER Industrial Temp. ..... °F. ...., 19.....  
SOURCE OF INFORMATION GR-3237

DRILLER or DIGGER .....

ADDITIONAL DATA:

Log ..... Water Level Measurements ..... Chemical Analysis ..... Aquifer Test .....

REMARKS: