

STATE ENGINEER
Salem, Oregon

JOSE
18133

Well Record

STATE WELL NO. 36/5W-31P
COUNTY JOSEPHINE
APPLICATION NO. GR-2504

OWNER: Grants Pass Golf Club, Inc.


MAILING ADDRESS: P. O. Box 601

LOCATION OF WELL: Owner's No.

CITY AND STATE: Grants Pass, Oregon

SE 1/4 SW 1/4 Sec. 31 T. 36 S., R. 5 W., W.M.

Bearing and distance from section or subdivision corner 1900' E. and 300' N.

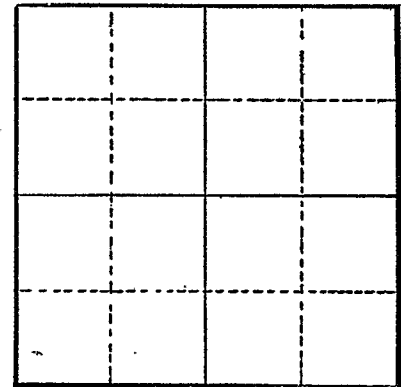

Section

Altitude at well

TYPE OF WELL: Drilled Date Constructed 1946

Depth drilled 222 Depth cased 222

CASING RECORD:

8-inch

FINISH:

Heavily perforated from ground to 132'

AQUIFERS:

WATER LEVEL:

27-feet

PUMPING EQUIPMENT: Type Fairbanks Morse H.P. 30
Capacity 200 G.P.M.

WELL TESTS:

Drawdown 97 ft. after hours Pumping 35 G.P.M.
Drawdown ft. after hours G.P.M.

USE OF WATER Irrigation Temp. °F. 19

SOURCE OF INFORMATION GR-2371

DRILLER or DIGGER Robert Burns, 4084 S. Pacific Highway, Grants Pass, Oregon

ADDITIONAL DATA:

Log Water Level Measurements Chemical Analysis Aquifer Test

REMARKS: