

STATE ENGINEER
Salem, Oregon


JOSE
18139

Well Record

STATE WELL NO. 36/5W-32A
COUNTY Josephine
APPLICATION NO. GR-3703

OWNER: B. L. Huston
MAILING ADDRESS: 2574 Fruitdale Road
CITY AND STATE: Grants Pass, Oregon

LOCATION OF WELL: Owner's No. _____
NE 1/4 NE 1/4 Sec. 32 T. 36 S., R. 5 W., W.M.
Bearing and distance from section or subdivision
corner 180' S. and 600' W. of NE cor. Sec. 32

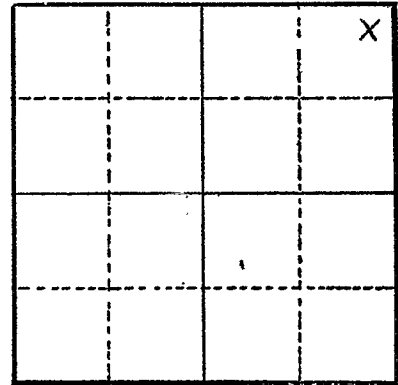

Section 32

Altitude at well _____

TYPE OF WELL: Drilled Date Constructed 8/1/52
Depth drilled 52 feet Depth cased 52 feet

CASING RECORD:

8 inch unperforated steel casing from 0 to 32 feet
8 inch perforated 1/2" x 3' casing from 32 to 52 feet

FINISH:

2 perforations per foot size 1/4" x 3' from 32 to 48 feet

AQUIFERS:

WATER LEVEL:

28 feet below surface

PUMPING EQUIPMENT: Type 2" jet pump electric H.P. 1 1/2
Capacity 30 G.P.M.

WELL TESTS:

Drawdown 15 ft. after _____ hours 30 G.P.M.
Drawdown _____ ft. after _____ hours _____ G.P.M.

USE OF WATER Irrigation Temp. _____ °F. _____, 19

SOURCE OF INFORMATION Well Registration Statement

DRILLER or DIGGER _____

ADDITIONAL DATA:

Log Water Level Measurements _____ Chemical Analysis _____ Aquifer Test _____

REMARKS:

Log: Red granite Thickness 32 Depth to Bottom
Gravelly granite 16 16