

STATE ENGINEER
Salem, Oregon

Jose
18197

Well Record

STATE WELL NO. 36/5N-29R
COUNTY Josephine
APPLICATION NO. GR-3702

OWNER: B. L. Huston


MAILING ADDRESS: 2574 Fruitdale Road ✓

LOCATION OF WELL: Owner's No.

CITY AND STATE: Grants Pass, Oregon

SE 1/4 SE 1/4 Sec. 29 T. 36 N. S. R. 5 W., W.M.

Bearing and distance from section or subdivision
corner 310' N. & 530' W. of SE cor. Sec. 29

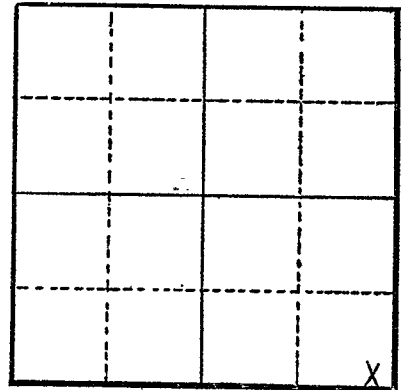

Section 29

Altitude at well

TYPE OF WELL: Drilled Date Constructed 8/1/52

Depth drilled 48 feet Depth cased 48 feet

CASING RECORD:

8 inch upperperated steel pipe from 0 to 20 feet
8 inch perforated 1/4" x 3' from 20 to 48 feet

FINISH:

2 perforations per foot size 1/4" x 3' from 20 to 46 feet

AQUIFERS:

WATER LEVEL:

26 feet below surface

PUMPING EQUIPMENT: Type Dorward 2" Jet pump H.P. 1 1/2
Capacity 25 G.P.M.

WELL TESTS:

Drawdown 15 ft. after 25 hours G.P.M.
Drawdown ft. after hours G.P.M.

USE OF WATER Irrigation Temp. °F. 19

SOURCE OF INFORMATION Well Registration Statement

DRILLER or DIGGER

ADDITIONAL DATA:

Log X Water Level Measurements Chemical Analysis Aquifer Test

REMARKS:

Log:

Granite and loam
Gravelly granite

Thickness	Depth to Bottom
20	28
28	