

STATE ENGINEER
Salem, Oregon

Well Record

STATE WELL NO. 34/6W-35N
COUNTY JOSEPHINE
APPLICATION NO. GR- 2022

OWNER: Martin M. & Minnie H. Gronowald

MAILING
ADDRESS:

LOCATION OF WELL: Owner's No.

CITY AND
STATE:

Grants Pass, Oregon

SW 1/4 SW 1/4 Sec. 35 T. 34 S., R. 6 W., W.M.

Bearing and distance from section or subdivision

corner 1000' E & 1200' N from SW cor Sec 35


Altitude at well

TYPE OF WELL: Drilled Date Constructed 1953

Depth drilled 133' Depth cased 133'

CASING RECORD:

8-inch

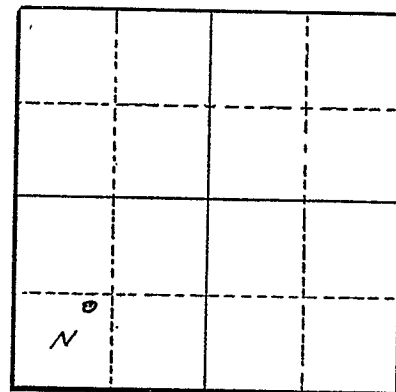

Section 35

FINISH:

perforated 0 to 133'

AQUIFERS:

WATER LEVEL:

2'

PUMPING EQUIPMENT: Type Dordard Jet Pump

H.P. 1 1/2

Capacity G.P.M.

WELL TESTS:

Drawdown ft. after hours 24 G.P.M.

Drawdown ft. after hours G.P.M.

USE OF WATER Irrigation

Temp. °F. 19

SOURCE OF INFORMATION GR-3915

DRILLER or DIGGER Pacquin & Story

ADDITIONAL DATA:

Log NA Water Level Measurements Chemical Analysis Aquifer Test

REMARKS: