

STATE ENGINEER  
Salem, Oregon

*Case  
17281*

# Well Record

STATE WELL NO. 35/5W-30A  
COUNTY JOSEPHINE  
APPLICATION NO. GR-3906

OWNER: John R. Nelson & Irene B. Nelson


MAILING ADDRESS: 23113 Dolorosa St.

LOCATION OF WELL: Owner's No. \_\_\_\_\_

CITY AND STATE: Woodland Hills, California

NE  $\frac{1}{4}$  NE  $\frac{1}{4}$  Sec. 30 T. 35 N. S., R. 5 E. W., W.M.

Bearing and distance from section or subdivision corner 800' S & 800' W from NE corner Section 30

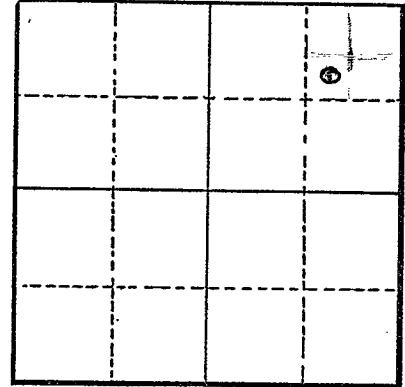

Section 30

Altitude at well \_\_\_\_\_

TYPE OF WELL: Drilled Date Constructed 1950

Depth drilled 115' Depth cased \_\_\_\_\_

### CASING RECORD:

8-inch

### FINISH:

Perforated

### AQUIFERS:

### WATER LEVEL:

5'

PUMPING EQUIPMENT: Type Pacific, Model 6 S & B-8-3 (Gen Elec Motor) H.P. 3  
Capacity 100 G.P.M.

### WELL TESTS:

Drawdown 65 ft. after \_\_\_\_\_ hours 1000 G.P.M.

Drawdown \_\_\_\_\_ ft. after \_\_\_\_\_ hours \_\_\_\_\_ G.P.M.

USE OF WATER Irrigation Temp. \_\_\_\_\_ °F. \_\_\_\_\_, 19\_\_\_\_

SOURCE OF INFORMATION GR-3829

DRILLER or DIGGER \_\_\_\_\_

### ADDITIONAL DATA:

Log NA Water Level Measurements \_\_\_\_\_ Chemical Analysis \_\_\_\_\_ Aquifer Test \_\_\_\_\_

### REMARKS: