

STATE ENGINEER
Salem, Oregon

Jose.
18518

Well Record

STATE WELL NO. 36/7W-2L ✓
COUNTY JOSEPHINE
~~APPLICATION NO.~~ GR-2306

OWNER: Hugh R. Haddock


MAILING ADDRESS: Rt. 2, Box 525

LOCATION OF WELL: Owner's No.

CITY AND STATE: Grants Pass, Oregon

NE 1/4 SW 1/4 Sec. 2 T. 36 N. S., R. 7 E. W., W.M.

Bearing and distance from section or subdivision corner 1320' E and 300' S.

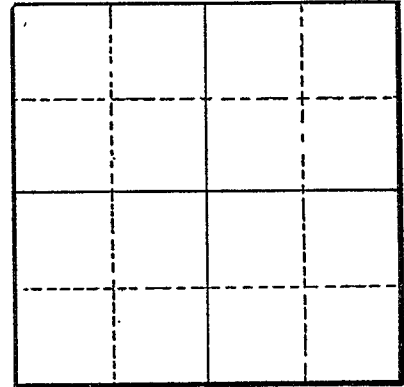

Section

Altitude at well

TYPE OF WELL: Drilled Date Constructed 1930

Depth drilled 156 Depth cased

CASING RECORD:

FINISH:

AQUIFERS:

WATER LEVEL:

46-feet

PUMPING EQUIPMENT: Type Dorward, electric H.P. 2
Capacity 25 G.P.M.

WELL TESTS:
Drawdown no ft. after hours Pumping 30 G.P.M.
Drawdown ft. after hours G.P.M.

USE OF WATER Irrigation Temp. °F. 19.
SOURCE OF INFORMATION GR-2199

DRILLER or DIGGER
ADDITIONAL DATA:
Log Water Level Measurements Chemical Analysis Aquifer Test

REMARKS: