

STATE ENGINEER  
Salem, Oregon

*Jose*  
*18974*

# Well Record

STATE WELL NO. 36/6W-36Q  
COUNTY JOSEPHINE  
APPLICATION NO. GR-2521

OWNER: Oris L Thetford


MAILING ADDRESS: Rt 4, Box 830

LOCATION OF WELL: Owner's No. \_\_\_\_\_

CITY AND STATE: Grants Pass

SW  $\frac{1}{4}$  SE  $\frac{1}{4}$  Sec. 36 T. 36 S., R. 6 W., W.M.

Bearing and distance from section or subdivision corner 490' N & 340' E from S corner

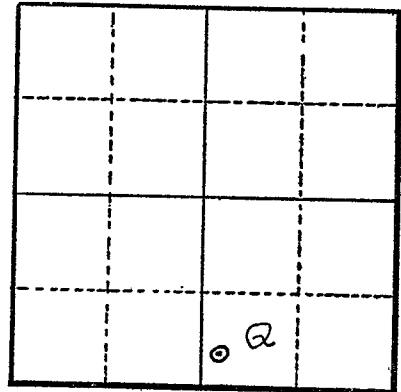

Section 36

Altitude at well \_\_\_\_\_

TYPE OF WELL: Drilled Date Constructed 1951

Depth drilled 120' Depth cased 120

### CASING RECORD:

6 5/8 - inch

### FINISH:

shoe at 120'

### AQUIFERS:

Decomposed granite  
Stratas of water

### WATER LEVEL:

8'

PUMPING EQUIPMENT: Type Pacific Jet

Capacity 25 G.P.M. H.P. 2

### WELL TESTS:

Drawdown 50 ft. after \_\_\_\_\_ hours 15 G.P.M.

Drawdown \_\_\_\_\_ ft. after \_\_\_\_\_ hours \_\_\_\_\_ G.P.M.

USE OF WATER Irrigation

Temp. \_\_\_\_\_ °F. \_\_\_\_\_, 19.

SOURCE OF INFORMATION GR-3878

DRILLER or DIGGER Roy H. Coleman

### ADDITIONAL DATA:

Log  Water Level Measurements \_\_\_\_\_ Chemical Analysis \_\_\_\_\_ Aquifer Test \_\_\_\_\_

### REMARKS:

Decomposed Granite	0'	to 120'
Stratas of water	10'	to 12'
Stratas of water	65'	to 68'
Stratas of water	90'	to 91'
Seepage	91'	to 115'