

STATE ENGINEER
Salem, Oregon

Jose
19310

Well Record

STATE WELL NO. 35/6W-3C
COUNTY JOSEPHINE
APPLICATION NO. GR-2373

OWNER: Henry A. Krasky

MAILING ADDRESS:

Rt. 1, Box 1060


LOCATION OF WELL: Owner's No. _____

CITY AND STATE:

Grants Pass, Oregon

NE $\frac{1}{4}$ NW $\frac{1}{4}$ Sec. 3 T. 35 N S., R. 6 E W., W.M.

Bearing and distance from section or subdivision corner 2100' E. and 230' S.

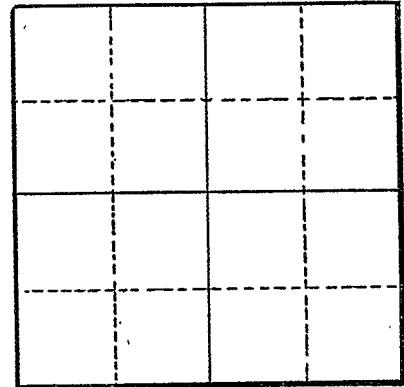

Section _____

Altitude at well _____

TYPE OF WELL: Drilled Date Constructed 1953

Depth drilled 140 Depth cased 140

CASING RECORD:

8-inch

FINISH:

AQUIFERS:

WATER LEVEL:

PUMPING EQUIPMENT: Type Pomona Turbine H.P. 2
Capacity 36 G.P.M.

WELL TESTS:

Drawdown _____ ft. after _____ hours _____ G.P.M.
Drawdown _____ ft. after _____ hours _____ G.P.M.

USE OF WATER Irrigation Temp. _____ °F., 19 _____

SOURCE OF INFORMATION GR-2254

DRILLER or DIGGER _____

ADDITIONAL DATA:

Log _____ Water Level Measurements _____ Chemical Analysis _____ Aquifer Test _____

REMARKS: