

STATE ENGINEER
Salem, Oregon

Jose
19333
Well Record

STATE WELL NO. 35/6W-10Q ✓
COUNTY JOSEPHINE
APPLICATION NO. GR-696

OWNER: Melvin Toothman

MAILING ADDRESS:


LOCATION OF WELL: Owner's No. _____

CITY AND STATE:

Grants Pass, Oregon

SW 1/4 SE 1/4 Sec. 10 T. 35 N. S., R. 6 W., W.M.

Bearing and distance from section or subdivision
corner 1875' W. of Est. Gov. corner and 702' N.

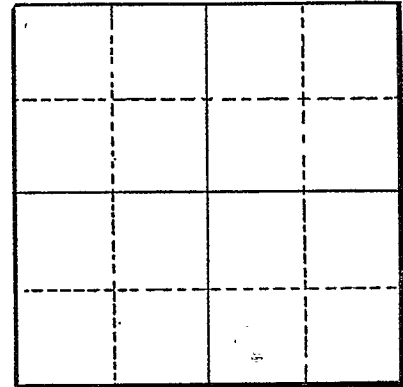

Section _____

Altitude at well _____

TYPE OF WELL: Drilled Date Constructed 1952

Depth drilled 195 Depth cased 192

CASING RECORD:

8-inch

FINISH:

Casing perforated - 3 per ft. - size 1/4" x 3" from 80 to 192

AQUIFERS:

Topsoil, clay, rock and gravel

WATER LEVEL:

50-feet

PUMPING EQUIPMENT: Type Pacific submersible

H.P. 4

Capacity 75 G.P.M.

WELL TESTS:

Drawdown 10 ft. after _____ hours Pumping 50 G.P.M.

Drawdown 70 ft. after _____ hours Pumping 80 G.P.M.

USE OF WATER Irrigation

Temp. _____ °F. _____, 19

SOURCE OF INFORMATION GR-2439

DRILLER or DIGGER _____

ADDITIONAL DATA:

Log Water Level Measurements _____ Chemical Analysis _____ Aquifer Test _____

REMARKS:

Topsoil 8 8
Clay & broken rock 52 60
Clay, brown & yellow 18 78
Clay & gravel, yellow - some water 32 110
Clay, yellow 27 137
Gravel & conglomerate & clay - water 31 168
Gravel - strong water 27 195