

STATE ENGINEER  
Salem, Oregon

Jose  
19409

# Well Record

STATE WELL NO. 38/7W-9R  
COUNTY JOSEPHINE  
APPLICATION NO. GR4090

OWNER: Raymond L. Frost & Loretta R. Frost MAILING ADDRESS: Rainbow Ranch

LOCATION OF WELL: Owner's No. CITY AND STATE: Selma, Oregon

SE 1/4 SE 1/4 Sec. 9 T. 38 N. S., R. 7 W., W.M.


Bearing and distance from section or subdivision corner 590' N & 810' W of SE cor Sec 9

TL 904

Altitude at well

TYPE OF WELL: Excavated Date Constructed 1948

Depth drilled 14' Depth cased

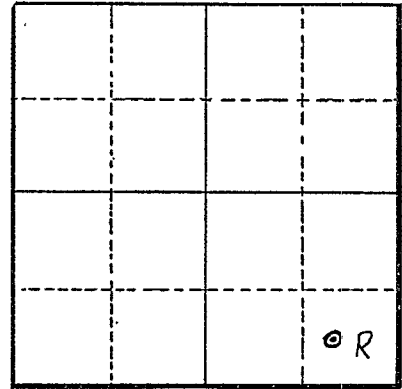

Section 9

### CASING RECORD:

### FINISH:

### AQUIFERS:

sandy loam  
gravel & fines

### WATER LEVEL:

5-10'

PUMPING EQUIPMENT: Type Berkley Centrifugal H.P. 15  
Capacity 1500 G.P.M.

### WELL TESTS:

Drawdown 8 ft. after 1500 hours G.P.M.  
Drawdown ft. after hours G.P.M.

USE OF WATER Irrigation Temp. °F., 19

SOURCE OF INFORMATION GR-3860

DRILLER or DIGGER NA

### ADDITIONAL DATA:

Log  Water Level Measurements Chemical Analysis Aquifer Test

### REMARKS:

sandy loam 4' to 4'  
gravel & fines - varying permeability 10' to 14'