

STATE ENGINEER
Salem, Oregon

Jose
19459

Well Record

STATE WELL NO. 39/5W-3A ✓
COUNTY Josephine
APPLICATION NO. GR-3124

OWNER: Harold Nathaniel Vencill


MAILING ADDRESS: Williams

LOCATION OF WELL: Owner's No.

CITY AND STATE: Oregon

NE 1/4 NE 1/4 Sec. 3 T. 39 N S, R. 5 W, W.M.

Bearing and distance from section or subdivision corner 235' N. 150' E.

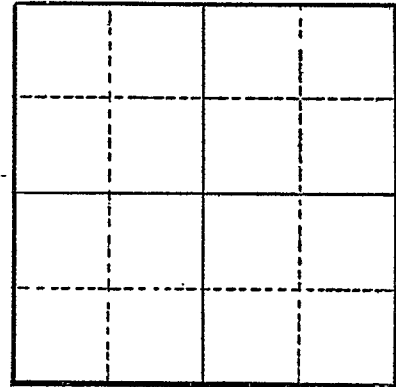

Section

Altitude at well

TYPE OF WELL: Dug Date Constructed 1948

Depth drilled 12' Depth cased

CASING RECORD:

FINISH:

AQUIFERS: Columbia Sandy Loam
Wash Gravel Water bearing

WATER LEVEL:
2'

PUMPING EQUIPMENT: Type Fairbanks Morse Centrifugal H.P. 7 1/2
Capacity 195 G.P.M.

WELL TESTS:
Drawdown 2 1/2' ft. after hours pumping 240 G.P.M.
Drawdown ft. after hours G.P.M.

USE OF WATER Irrigation Temp. °F., 19

SOURCE OF INFORMATION GR-2931

DRILLER or DIGGER

ADDITIONAL DATA:

Log Water Level Measurements Chemical Analysis Aquifer Test

REMARKS:

Columbia Sandy Loam 2 12
Wash Gravel water bearing 10 12