

STATE ENGINEER
Salem, Oregon

*Joel
19510*

Well Record

STATE WELL NO. 39/7W-31J(1)
COUNTY Josephine
APPLICATION NO. GR-197

OWNER: C. J. Moser


MAILING ADDRESS: 1500 Lawnridge Ave.

LOCATION OF WELL: Owner's No. #2

CITY AND STATE: Grants Pass, Oregon

NE 1/4 SE 1/4 Sec. 31 T. 39 M. S., R. 7 E. W., W.M.

Bearing and distance from section or subdivision corner 2300' N and 200' W SW cor. Sec. 32

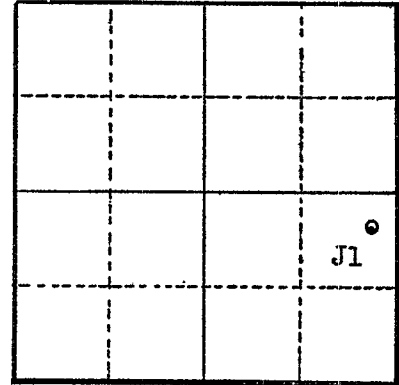

Section 31

Altitude at well 1460' Interpolated

TYPE OF WELL: Infil. trench Date Constructed 5/1/50

Depth drilled 8' Depth cased _____

CASING RECORD:

None

FINISH:

None

AQUIFERS:

Unknown

WATER LEVEL:

4' below land surface

PUMPING EQUIPMENT: Type 8" suction pump Atlas Diesel H.P. 20
Capacity 2000 G.P.M.

WELL TESTS:

Drawdown _____ ft. after _____ hours _____ G.P.M.
Drawdown _____ ft. after _____ hours _____ G.P.M.

USE OF WATER Irrigation 24 acres Supple. Temp. _____ °F. _____, 19____

SOURCE OF INFORMATION Registration Statement GR-197

DRILLER or DIGGER _____

ADDITIONAL DATA:

Log No Water Level Measurements _____ Chemical Analysis _____ Aquifer Test _____

REMARKS:

24 acres supplemental to adj. right - Sucker Creek Decree